
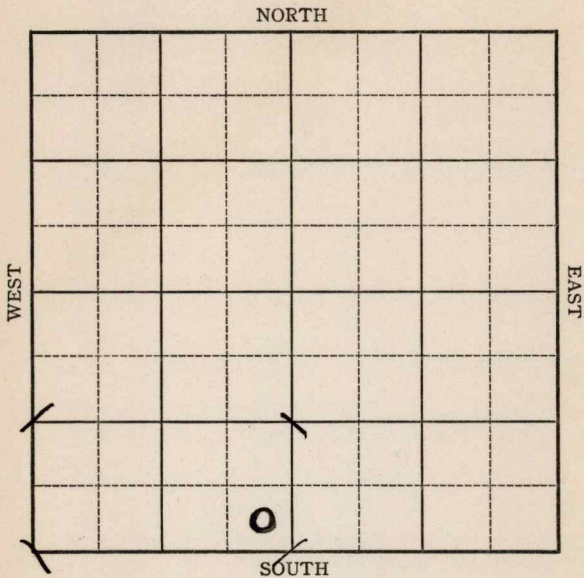


Section 15 Township 19 Range 9W

Well No. 1 Cramm

Company Continental

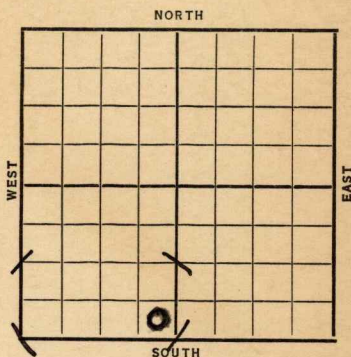

Sec. 15 Twp. 19 R. 9-WWell No. #1 Cramm FarmContinental Company Ft. from N. Line330 Ft. from S. Line330 Ft. from E. Line Ft. from W. Line**Special**

Date	REPORT	Elev. 1686
1937		
7/28	Location	
8/6	T.D. 190'. Rng. 10".	
8/13	Dr lg. 2260'.	
8/20	K.C. 2863'. Sil. 3189'.	
	T.D. 3196'.	
8/27	Top Siliceous 3187 (Corrected)	
	T.D. 3196 Drilled plug	
	Filled up 500 feet oil in 2 hours	
	Filled up 1250 feet in 12 hours	
	Drilled 5 feet deeper T.D. 3201	
	Had increase in oil Now have 2200	
	feet oil in hole Shut down for	
	tanks (Tel)	
9/3	" " "	
9/10	Acidized 3000 gallons Pumped 61 bbls.	
	in 14 hrs. Pump 50 bbls. next 4 hrs.	
	Made 160 bbls. salt water in 8 hrs.	
	Potential 302 bbls. 24 hrs.	
	Will PB to bottom 7" and drill out to	
	oil pay (Tel)	

OVER

1937

9/17 Pumped 61.64 bbls. 4 hrs and
50.4 bbls. 4 hrs & 160 bbls.
water in 8 hrs.

Potential 302 bbls.

P.B. to shut off water.

9/24 " " " "

10/2 P.B. 3164'.

10/8 7" @ 3188'. T.D. 3201'.

Swab 67 B.O. & 1/3 B.W. in 8
hrs. Then Swab 4 BOPH W/SW.

10/15 1000 acid. Pumped 173 B.O. 6
hrs.

10/21 6" @ 3188'.

Sil. 3187'.

T.D. 3201'.

3000 acid.

Pump 61.64 bbls. 4 hrs &
50.4 bbls. 4 hrs.

Pot. 300 oil & 480 water.

Reacidized with 1000 but
didn't help.

COMPLETED

Rice KANSAS

Map No. _____ Sec. 15 Twp. 19 R. 9^WWell No. 1-CrammContinental Company

Contractor _____


FIRST REPORT

SECTION PLAT

_____ Ft. from N. Line

530 Ft. from S. Line330 Ft. from E. Line

_____ Ft. from W. Line

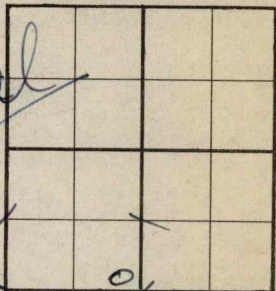

Location _____

Rig up _____

Drilling and Remarks: _____

RECORD

Cased _____ in., _____ ft.

Sand _____

Gas _____

Oil _____

Total Depth _____

PRODUCTION

1st 24 hrs. Nat. _____

1st 24 hrs. after shot _____

Gas _____ Cu. Ft.

Dry Hole _____

Abandoned _____

Date

JUL 28 1931 19

H. D. Hatfield Scout

Map No. 49 Sec. 15 Twp. 19 9WWell No. 1 CrammContinental Company

Contractor

COMPLETED

SE SW

SECTION PLAT

_____ Ft. from N. Line

330 Ft. from S. Line330 Ft. from E. Line

_____ Ft. from W. Line

Location _____

RECORD

Cased 6 in., 3188 ft.Sand 511 3187

Gas _____

Oil _____

Total Depth 3201

PRODUCTION

1st 24 hrs. Nat. _____

1st 24 hrs. after shot _____

Gas _____ Cu. Ft.

Dry Hole _____

Abandoned _____

Drilling and Remarks:

3000 Acid.P-61.64 / 4 + 50.4 / 4POT- 300 oil
480 waterReacidized w/1000 but
didn't help.

Date

OCT 20 1937

19

H. D. Hatfield Scout