

Section 15 Township 19 Range 9-W

Well No. #2 Cramm


Company Bishop Oil

Cramm Pool

NORTH

WEST

EAST

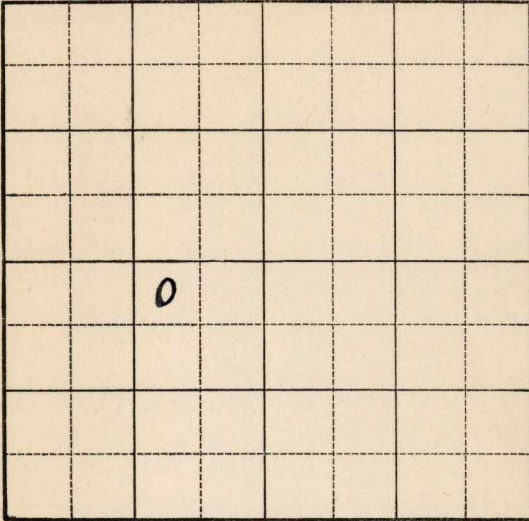

SOUTH



1940

1/31

Arb. 3206'

5" - 3210'

T.D. 3230'

1500 acid.

Pump 15 bbls. oil.

**COMPLETED**

Map No. 49 Sec. 15 Twp. 19 R. 9W

Well No. 2 Cramm

Bishop Oil

Company

Contractor

FIRST REPORT

SECTION PLAT

NW NE SW

330 Ft. from N. Line

\_\_\_\_\_ Ft. from S. Line

990 Ft. from E. Line

\_\_\_\_\_ Ft. from W. Line

	o		

CRAMM POOL

Location \_\_\_\_\_

Rig up \_\_\_\_\_

Drilling and Remarks:

**Rotary**

RECORD

Cased \_\_\_\_\_ in., \_\_\_\_\_ ft.

Sand \_\_\_\_\_

Gas \_\_\_\_\_

Oil \_\_\_\_\_

Total Depth \_\_\_\_\_

PRODUCTION

1st 24 hrs. Nat. \_\_\_\_\_

1st 24 hrs. after shot \_\_\_\_\_

Gas \_\_\_\_\_ Cu. Ft.

Dry Hole \_\_\_\_\_

Abandoned \_\_\_\_\_

Date

NOV 1 1939 19

S. J. LEWIS Scout

Map No. 49 Sec. 15 Twp. 19 R. 9W

Well No. 2 Cramm

Bishop Oil

Company

Contractor

**COMPLETED**

**SECTION PLAT**

NW NE SW

330 Ft. from N. Line

\_\_\_\_\_ Ft. from S. Line

990 Ft. from E. Line

\_\_\_\_\_ Ft. from W. Line

CRAMM POOL

	o		

Location \_\_\_\_\_

Rig up \_\_\_\_\_

Drilling and Remarks:

*Cr 83206*

*5" @ 3210*

*1500 acid*

*Pump 15 1/2 hp*

**RECORD**

Cased \_\_\_\_\_ in., \_\_\_\_\_ ft.

Sand \_\_\_\_\_

Gas \_\_\_\_\_

Oil \_\_\_\_\_

Total Depth 3230

**PRODUCTION**

1st 24 hrs. Nat. \_\_\_\_\_

1st 24 hrs. after shot \_\_\_\_\_

Gas \_\_\_\_\_ Cu. Ft.

Dry Hole \_\_\_\_\_

Abandoned \_\_\_\_\_

Date

JAN 31 1940 19

S. J. LEWIS

Scout