


Section 15 Township 19 Range 9-W

Well No. #2 Cramm

Company ~~Comanche Oil~~ Harwood Oil

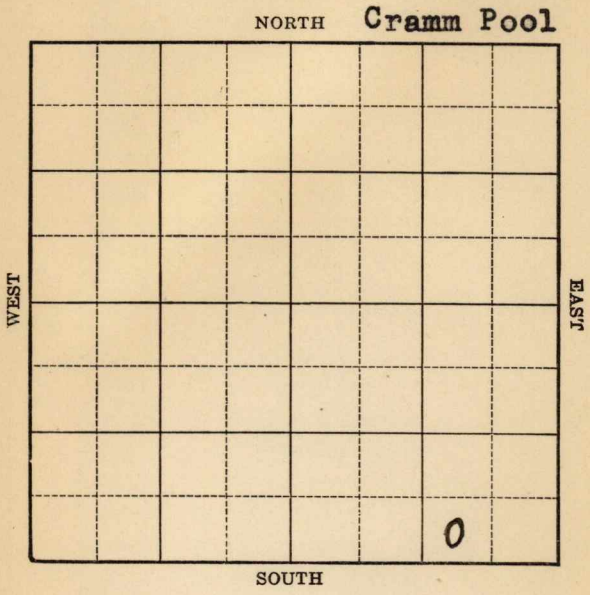


KANSAS

Rice

Sec. 15 Twp. 19 R. 9-WWell No. #2 Cramm Farm~~Comanche Oil~~ Harwood Oil Company

(Cramm)

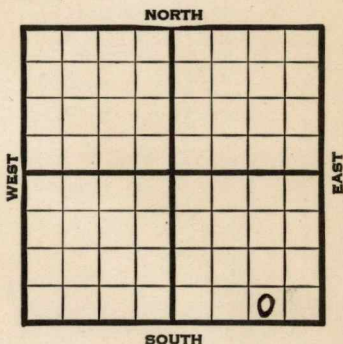 Ft. from N. Line330 Ft. from S. Line990 Ft. from E. Line Ft. from W. Line

Elev. 1709

1939	REPORT
8/16.	Rotary.
8/24	10" - 132' Drlg. 1860'
8/31	Topeka 2436' Lans. 2865'
	Cong. 3190' Drlg. 3226'
9/7	Arb. 3224' 5" - 3226'
	T.D. 3241' 1100' oil 6 hours.
9/13	Arb. 3224'
	5" - 3226'
	T.D. 3241'
	Potential 77 bbls., pump.
	COMPLETED

Rice

KANSAS

Map No. 49 Sec. 15 Twp. 19 R. 9WWell No. 2 Cramm

Comanche Oil

Company

Contractor

FIRST REPORT

SECTION PLAT

SW SE SE

Ft. from N. Line

330 Ft. from S. Line990 Ft. from E. Line

Ft. from W. Line

CRAMM POOL

			o

Location _____

Rig up _____

Drilling and Remarks:

ROTARY

RECORD

Cased _____ in., _____ ft.

Sand _____

Gas _____

Oil _____

Total Depth _____

PRODUCTION

1st 24 hrs. Nat. _____

1st 24 hrs. after shot _____

Gas _____ Cu. Ft.

Dry Hole _____

Abandoned _____

Date

AUG 16 1939 19

S. J. LEWIS

Scout

KANSAS *Rice*Map No. 49 Sec. 15 Twp. 19 R. 9WWell No. 2 CrammHarwood Oil CompanyB. W. B. E. E Contractor

CORRECTION

 Ft. from N. Line380 Ft. from S. Line990 Ft. from E. Line Ft. from W. Line**SECTION PLAT**

			o

Cramm PoolLocation Rig up

Drilling and Remarks:

*Reported as
Comanche Oil***RECORD**Cased in., ft.Sand Gas Oil Total Depth **PRODUCTION**1st 24 hrs. Nat. 1st 24 hrs. after shot Gas Cu. Ft.Dry Hole Abandoned

Date

AUG 23 1939

19

S. J. LEWIS

Scout

KANSAS

Rice

Map No. _____ Sec. 15 Twp. 19 R. 9WWell No. 2 CrammHarwood Oil

Company _____

Contractor _____

COMPLETED
SW SE SE

SECTION PLAT

			0

_____ Ft. from N. Line

330 Ft. from S. Line990 Ft. from E. Line

_____ Ft. from W. Line

CRAMM POOL

Location _____

Rig up _____

Drilling and Remarks:

*Cu & 3224**5" C 3226**Pump 77 P & X.*

RECORD

Cased _____ in., _____ ft.

Sand _____

Gas _____

Oil _____

Total Depth 3241

PRODUCTION

1st 24 hrs. Nat. _____

1st 24 hrs. after shot _____

Gas _____ Cu. Ft.

Dry Hole _____

Abandoned _____

Date

SEP 13 1939

19

S. J. LEWIS

Scout