

KANSAS


Rice

Form 51—5M—7-39—Palace

Section 15 Township 19 Range 9-W

Well No. #3 Cramm

Company Harwood

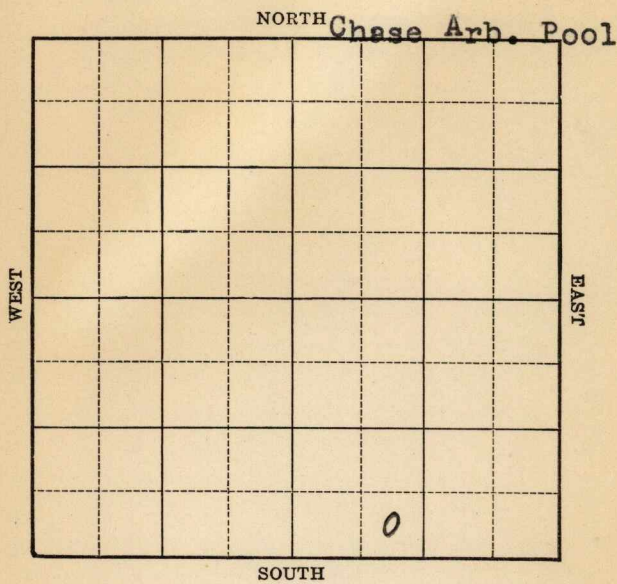

Map No. _____ Sec. 15 Twp. 19 R. 9WWell No. 3 CrammHarwood

Company _____

Contractor _____

FIRST REPORT

SE SW SE

_____ Ft. from N. Line

990 Ft. from S. Line

_____ Ft. from E. Line

990 Ft. from W. Line

SECTION PLAT

CHASE ARB. POOL

Location _____

Rig up _____

Drilling and Remarks:

Rotary

RECORD

Cased _____ in., _____ ft.

Sand _____

Gas _____

Oil _____

Total Depth _____

PRODUCTION

1st 24 hrs. Nat. _____

1st 24 hrs. after shot _____

Gas _____ Cu. Ft.

Dry Hole _____

Abandoned _____

Date

JAN 10 1940 19

S. J. LEWIS

Scout

Map No. 49 Sec. 15 Twp. 19 R. 9WWell No. 3 CrammHarwood

Company

CORRECTION

Contractor

SE SW SE

Ft. from N. Line

330 Ft. from S. Line

Ft. from E. Line

990 Ft. from W. Line

CHASE ARB. POOL

SECTION PLAT

Location _____

Rig up _____

Drilling and Remarks:

Rotary
Reported

990 x 990

RECORD

Cased _____ in., _____ ft.

Sand _____

Gas _____

Oil _____

Total Depth _____

PRODUCTION

1st 24 hrs. Nat. _____

1st 24 hrs. after shot _____

Gas _____ Cu. Ft.

Dry Hole _____

Abandoned _____

Date

JAN 10 1940


19

S. J. LEWIS

Scout

Check spot & feet measurements.
 According to feet measurements
 well would be in NE SW SE but drilling
 report shows well in SE SW SE.

Paul.

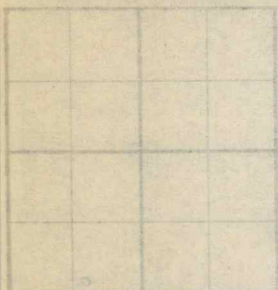

_____ Ft. from N. line
 990 _____ Ft. from S. line
 _____ Ft. from E. line
 990 _____ Ft. from W. line

CHASE ARB. POOL

RECORD

Location

Cased

Sand

Gas

Drilling and Remarks

Rotary

- Misc. Small Maps
- Cards
- Tracing
- France Map
- Scarborough Map
- Moody Map
- Geological Dept.
- Moody Flat Book

Date

Rice

KANSAS

Map No. 49 Sec. 15 Twp. 19 R. 9WWell No. 3 Cramm

Harwood

Company

Contractor

COMPLETED

SE SW SE

SECTION PLAT

_____ Ft. from N. Line

330 Ft. from S. Line

_____ Ft. from E. Line

990 Ft. from W. Line

CHASE ARB. POOL

Location _____

Rig up _____

Drilling and Remarks:

*Cr 83237**5" C 3237**2000 acid**Depthograph Pot**510*

RECORD

Cased _____ in., _____ ft.

Sand _____

Gas _____

Oil _____

Total Depth 3258

PRODUCTION

1st 24 hrs. Nat. _____

1st 24 hrs. after shot _____

Gas _____ Cu. Ft.

Dry Hole _____

Abandoned _____

Date

FEB 14 1940

19

S. J. LEWIS

Scout