


Section 15 Township 19 Range 9-W

Well No. #3 Cramm

Company McPherson Drlg.

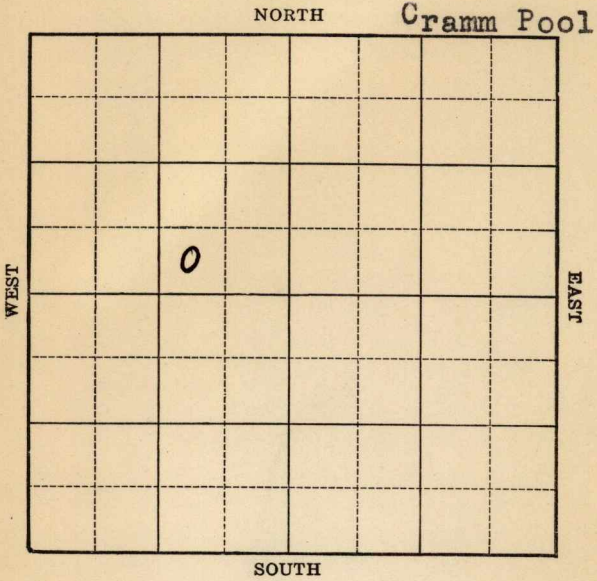

Sec. 15 Twp. 19 R. 9-W

Well No. #3 Cramm Farm \_\_\_\_\_

McPherson Drlg. Company \_\_\_\_\_


(Cramm)

\_\_\_\_\_ Ft. from N. Line

330 Ft. from S. Line

990 Ft. from E. Line

\_\_\_\_\_ Ft. from W. Line

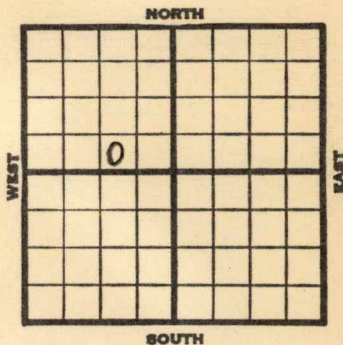

**Elev. 1700**

1939	REPORT
9/27	Rotary.
10/5	13" - 121' Anhy 320' Drlg. 1951'
10/12	Lans. 2878' Drlg. 3032'
10/19	Arb. 3188' 8" - 3188' T.D. 3200½' 500 acid.
10/26	1000 acid. Testing.
11/1	Arb. 3188' 8" - 3188' T.D. 3200½' 1500 acid. Depthograph potential 1042 bbls.

**COMPLETED**

Map No. 49 Sec. 15 Twp. 19 R. 9W

Well No. 3 Cramm

McPherson Drlg. Company

Contractor

FIRST REPORT

SW SE NW

SECTION PLAT


         Ft. from N. Line

330 Ft. from S. Line

990 Ft. from E. Line

         Ft. from W. Line

CRAMM POOL

Location                                 

Rig up                                 

Drilling and Remarks: Rotary

RECORD

Cased          in.,          ft.

Sand                                 

Gas                                 

Oil                                 

Total Depth                         

PRODUCTION

1st 24 hrs. Nat.                         

1st 24 hrs. after shot                         

Gas                                  Cu. Ft.

Dry Hole                                 

Abandoned                                 

Date

SEP 27 1939 19

S. J. LEWIS Scout

Map No. 49 Sec. 15 Twp. 19 R. 9W

Well No. 3 Cramm

MoPherson Drilling

Company

Contractor

COMPLETED

SECTION PLAT

SW SE NW

\_\_\_\_\_ Ft. from N. Line

330 Ft. from S. Line

990 Ft. from E. Line

\_\_\_\_\_ Ft. from W. Line


CRAMM POOL

RECORD

Location \_\_\_\_\_

Cased \_\_\_\_\_ in., \_\_\_\_\_ ft.

Rig up \_\_\_\_\_

Sand \_\_\_\_\_

Drilling and Remarks:

Gas \_\_\_\_\_

*Art 3188*

Oil \_\_\_\_\_

*8" @ 3188*

Total Depth 3200 1/2

*1500 Acid*

*Depthograph Set*

*1042*

PRODUCTION

1st 24 hrs. Nat. \_\_\_\_\_

1st 24 hrs. after shot \_\_\_\_\_

Gas \_\_\_\_\_ Cu. Ft.

Dry Hole \_\_\_\_\_

Abandoned \_\_\_\_\_

Date

NOV 1 1939

19

S. J. LEWIS

Scout