

KANSAS


FORM 51 5M 1-42 PETROL

Rice

Section 15 Township 19 Range 9-W

Well No. #5 Cramm

Company Bishop Oil

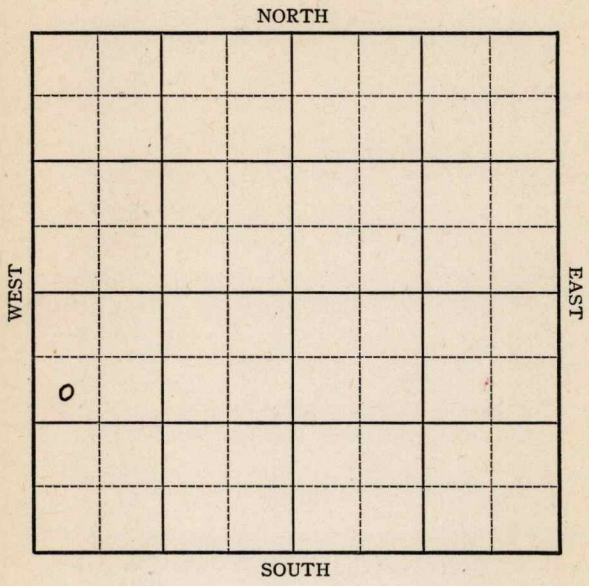

KANSAS

Rice


Sec. 15 Twp. 19 R. 9-WWell No. #5 Cramm FarmBishop Oil Company990 Ft. from N. Line

Ft. from S. Line

Ft. from E. Line

330 Ft. from W. Line

Chase Pool Elev. 1698

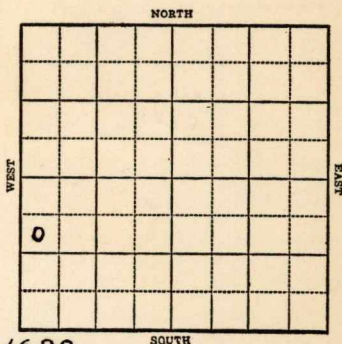

1943

R E P O R T

7/28 Location

8/4 "

8/11 "

8/18 "

8/25 "

9/1 "

9/8 "

9/15 Rotary

9/22 8" @ 197'
Drlg. 2205'

9/29 Lans 2868

BKC 3148

Cong 3170

Drlg. 3200'

10/6 Arb 3204-09 T.D.

5" @ 3204

Must

10/13 T.D. 3222-200 acid

Pump 5 oil per hr 6 hrs.

OVER

1943
10/20

Arb 3204

5" @ 3204

2000 acid

Pump 180 Pot.

T.D. 3222'

GRAVity 42

COMPLETED

KANSAS

Map No. 49 Sec. 15 Twp. 19 R. 9WWell No. 5 CrammBishop Oil CompanyFIRST REPORT Contractor

SW NW SW

SECTION PLAT

990 Ft. from N. Line Ft. from S. Line Ft. from E. Line330 Ft. from W. Line

o			

CHASE POOL

Location XXXRig up

Drilling and Remarks:

RECORD

Cased in., ft.Sand Gas Oil Total Depth

PRODUCTION

1st 24 hrs. Nat. 1st 24 hrs. after shot Gas Cu. Ft.Dry Hole Abandoned

Date

JUL 28 1943 19 S. J. LEWIS Scout

KANSASMap No. 47 Sec. 15 Twp. 19 R. 9WWell No. 5 CrammBishop Oil

Company

COMPLETED

Contractor

SW NW SW

SECTION PLAT

6			

990 Ft. from N. Line Ft. from S. Line Ft. from E. Line330 Ft. from W. LineChase PoolLocation Rig up

Drilling and Remarks:

Cr 3204
5" @ 3204
2000 acid
Pump 150 Bx

42°/42

RECORD

Cased in., ft.Sand Gas Oil Total Depth 3222

PRODUCTION

1st 24 hrs. Nat. 1st 24 hrs. after shot Gas Cu. Ft.Dry Hole Abandoned

Date

OCT 20 1943 19S. J. LEWIS

Scout