


Rice

Form 51—5M—11-38—Palace

Section 15 Township 19 Range 9-WWell No. 3 Cramm "A"Company Shell et al

NORTH Cramm Pool

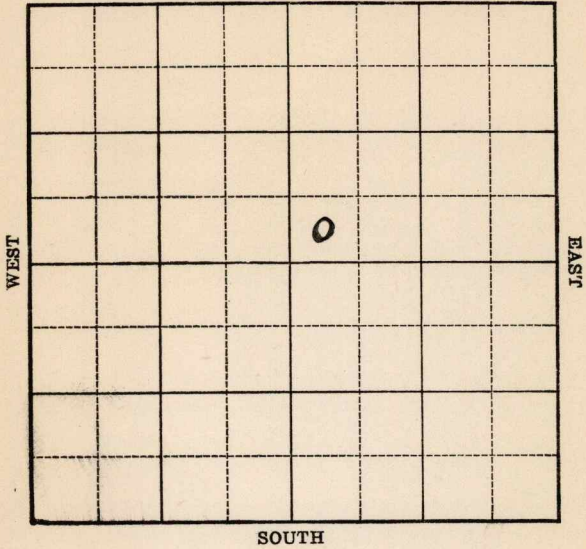

KANSAS

Rice

Sec. 15 Twp. 19 R. 9-W

Well No. #3 Cramm "A" Farm

Shell et al

Company


(Cramm)

Ft. from N. Line

330 Ft. from S. Line

_____ Ft. from E. Line

330 Ft. from W. Line

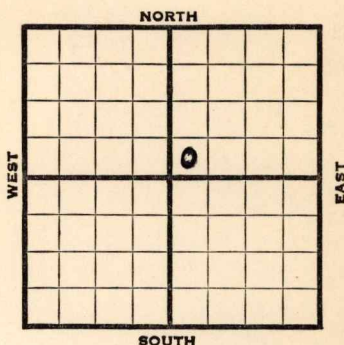

Elev. 1709'

1939	REPORT
4/5	9" - 178' WOC.
4/14	Drl g. 2411'
4/21	Topeka 2445' Lans. 2886'
	Cong. 3184' Simp. 3211'
	Arb. 3230-33' 4" - 3231' RUST.
4/26	4" - 3231'
	Arb. 3230'
	T. D. 3241'
	2000 acid.
	Swab 73 oil in 8 hours.
	Potential 165 bbls.
	COMPLETED

Rice

KANSAS

Map No. 49 Sec. 15 Twp. 19 R. 9WWell No. 3 Cramm "A"

Shell etal

Company

Contractor

FIRST REPORT

SW NE

SECTION PLAT

		0	

 Ft. from N. Line330 Ft. from S. Line Ft. from E. Line330 Ft. from W. Line

CRAMM POOL

Location Rig up

Drilling and Remarks:

9" - 178

WOC

RECORD

Cased in., ft.Sand Gas Oil Total Depth

PRODUCTION

1st 24 hrs. Nat. 1st 24 hrs. after shot Gas Cu. Ft.Dry Hole Abandoned

Date

APR 5 - 1939

19

H. D. Hatfield

Scout

Rice

Map No. 49 Sec. 15 Twp. 19 R. 9WWell No. 3 Cramm "A"

Shell et al

Company

Contractor

COMPLETED

SECTION PLAT

SW NE

Ft. from N. Line

330 Ft. from S. Line

Ft. from E. Line

330 Ft. from W. Line

CRAMM POOL

Location

Rig up

Drilling and Remarks:

2000 Acid

Swb 73 oil in 8 hrs

Pot 165

RECORD

Cased 4 in. 3231 ft.Sand A-B 3230

Gas

Oil

Total Depth 3241

PRODUCTION

1st 24 hrs. Nat.

1st 24 hrs. after shot

Gas

Cu. Ft.

Dry Hole

Abandoned

Date

APR 26 1939

19

H. D. Hatfield Scout