


Section 15 Township 19 Range 9-W

Well No. #4 Cramm "A"

Company Shell et al

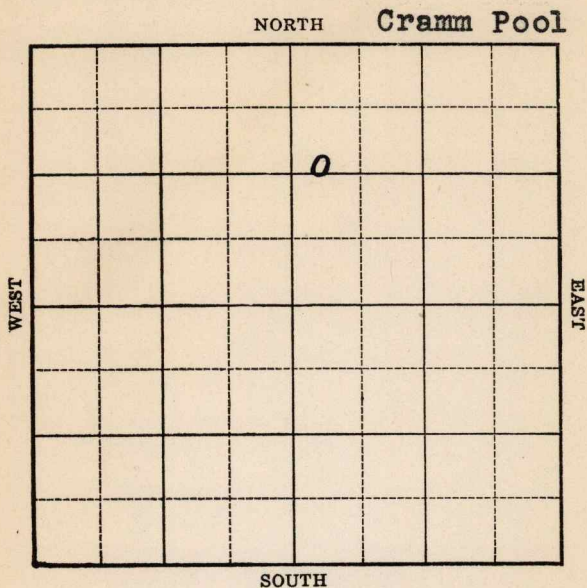

Rice

KANSAS

Map No. 49 Sec. 15- Twp. 19 R. 9WWell No. 4 Cramm "A"Shell etal

Company

Contractor

FIRST REPORT

C W L NE

1301 Ft. from N. Line Ft. from S. Line Ft. from E. Line330 Ft. from W. Line

SECTION PLAT

		0	

CRAMM POOL

Location Rig up

Drilling and Remarks:

Rotary

RECORD

Cased in., ft.Sand Gas Oil Total Depth

PRODUCTION

1st 24 hrs. Nat. 1st 24 hrs. after shot Gas Cu. Ft.Dry Hole Abandoned

Date

JUL 5 1939 19

S. J. LEWIS Scout

Rice

KANSAS

Map No. 49 Sec. 15 Twp. 19 R. 9WWell No. 4 Cramm "A"Shell et al

Company

Contractor

COMPLETED

C W L N E

1301 Ft. from N. Line

_____ Ft. from S. Line

_____ Ft. from E. Line

330 Ft. from W. Line

SECTION PLAT

		0	

CRAMM POOL

Location _____

Rig up _____

Drilling and Remarks:

*Ar 83213**4" @ 3214**Depthograph Pox**3634**Maximum 3000*

RECORD

Cased _____ in., _____ ft.

Sand _____

Gas _____

Oil _____

Total Depth 8222

PRODUCTION

1st 24 hrs. Nat. _____

1st 24 hrs. after shot _____

Gas _____ Cu. Ft.

Dry Hole _____

Abandoned _____

Date

AUG 16 1939

19

S. J. LEWIS

Scout