

KANSAS

Rice

FORM 51 5M 10-41 PETROL

Section 15 Township 19 Range 9-W

Well No. #5 Patton "B"


Company McPherson Drlg.

Chase Pool

NORTH

WEST

EAST

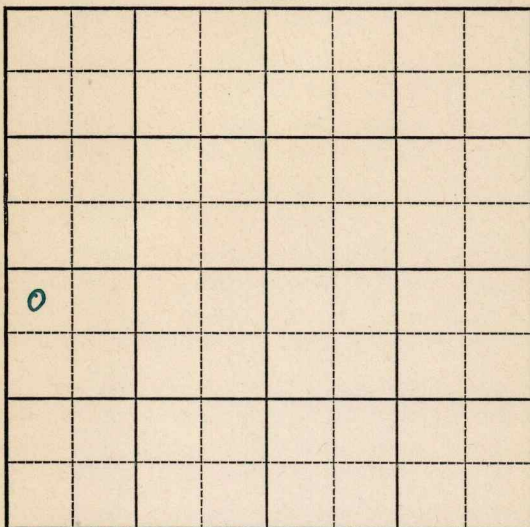

SOUTH

KANSAS

Rice

Sec. 15 Twp. 19 R. 9-W

Well No. #5 Patton "B" Farm

McPherson Drlg. Company


(Chase)

330 Ft. from N. Line

_____ Ft. from S. Line

_____ Ft. from E. Line

330 Ft. from W. Line

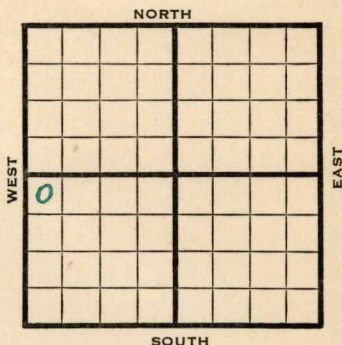

1942

REPORT

7/8

Derrick.

7/15

Location abandoned.

ABANDONED

Rice

KANSAS

Map No. 49 Sec. 15 Twp. 19 R. 9WWell No. 5 Patton "B"

McPherson Drlg.

Company

FIRST REPORT

Contractor

NW SW

SECTION PLAT

330 Ft. from N. Line

Ft. from S. Line

Ft. from E. Line

330 Ft. from W. Line

0			

CHASE POOL

Location

Rig up

Drilling and Remarks:

Derrick

RECORD

Cased _____ in., _____ ft.

Sand _____

Gas _____

Oil _____

Total Depth _____

PRODUCTION

1st 24 hrs. Nat. _____

1st 24 hrs. after shot _____

Gas _____ Cu. Ft.

Dry Hole _____

Abandoned _____

Date

JUL 8 1942 19

S. J. LEWIS Scout

Rice

KANSAS

Map No. 49 Sec. 15 Twp. 19 R. 9WWell No. 5 Patton "B"McPherson Drilling CompanyABANDONED Contractor

NW SW

SECTION PLAT

0			

330 Ft. from N. Line Ft. from S. Line Ft. from E. Line330 Ft. from W. LineCHASE POOLLocation ✓Rig up

Drilling and Remarks:

RECORD

Cased in., ft.Sand Gas Oil Total Depth

PRODUCTION

1st 24 hrs. Nat. 1st 24 hrs. after shot Gas Cu. Ft.Dry Hole Abandoned

Date

JUL 15 1942 19S. J. LEWIS Scout