McPherson


DX 78-1

KANSAS

Section 11 Township 21 Range 2W

Well No. #1 Regier

Company Don T. Ingling

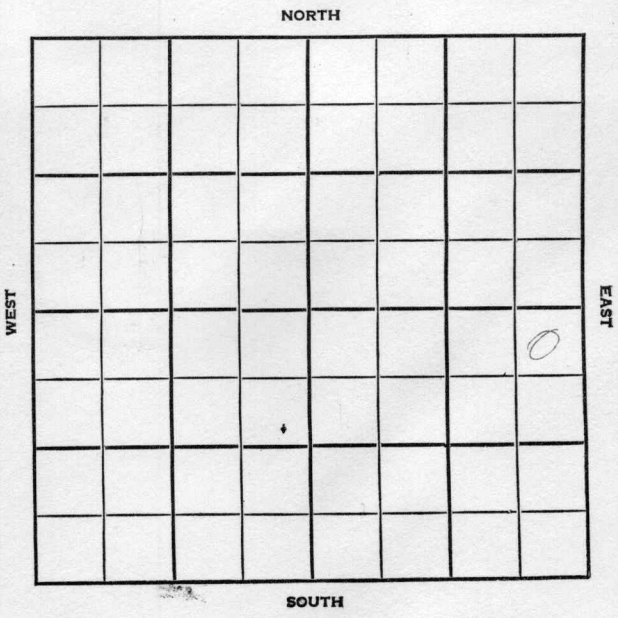

FORM 513 SUNRAY

County McPherson Elev.

Sec. 11 Twp. 21 Rge. 2W

Company Don T. Ingling

Farm Name Regier No. 1

TOPS	DEPTH	LOG	DATUM
Anh.			
T.P.			
H.			
Tr.			
Dg.			
B.L.			
L.			
K.C.			
B.K.C.			
Ce.			
C.			
M.			
M.			
K.			
Mz.			
Mo.			
V.			
S.			
S.			
A			
R.			
P€.			
G.			
T.D.			

Loc. in Sec. NE NE SE

Geol.

Contr. Co. Tools

Pool Semi- WC



Date Comm. MIRT

Co. Lse. No. Sec. T. R.

FORM 513 SUNRAY

County McPherson Elev.

Sec. 11 Twp. 21 Rge. 2W

Company Don T. Ingling

Farm Name Regier No. 1

TOPS	DEPTH	LOG	DATUM
Anh.			
Tp.			
H.			
Tr.			
Dg.			
Bl.			
L.	2319		
K.C.			
B.K.C.			
Ce.			
C.			
M. chat	2958		
M.			
K.			
Mz.			
Mo.			
V.			
S.			
S.			
A			
R.			
P€.			
G.			
T.D.	3022		

Loc. in Sec. NE NE SE

Geol.

Contr. Co. Tools

Pool Semi- WC

ABANDONED

NOV 7 '56

Date Comm.

MIRT OCT 24 '56 10-18-56 8 5/8

175/75 S.O @ 175 OCT 31 '56 D

1975 NOV 7 '56 DST 2962-90 op 1 hr

G/sore TSTM rec 30' md

DHP 680

D&A

Co. Lse. No. Sec. T. R.