

KANSAS

See.

Twp.

R

Farm

Company

NORTH

WEST

EAST

SOUTH

Location

Drilling Remarks

Rig Up

Drilling Remarks

RECORD

Cased _____ in. _____ ft.

Sand

Gas.

Oil

Total Depth

PRODUCTION

1st 24 hrs. Nat.

1st 24 hrs. after shot


Gas ----- cu. ft.

Dry Hole

Abandoned

Map No. **KANSAS** Sec. 16 Twp. 19 R. 9^wWell No. 1- Collis FarmLebow, Weaver & Jones Co Company

NORTH

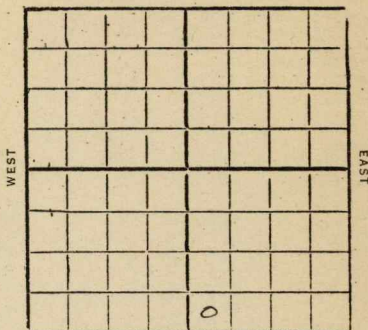

Ft. from N. Line

365 Ft. from S. Line

Ft. from E. Line

330 Ft. from W. Line

SOUTH

Date

REPORT

Date	REPORT
10/5	Loc
10/12	Bldg reg
10/19	
10/26	Regn up
11/2	Spdg.
11/9	15" 610
	dreg 825'
11/15	" 1400'
11/23	12" 1525
	dreg 1950'
11/30	show gas 2000'
	10" 2075
	3 bailer water 2170-80
	TD 2260' U/B 10"
12/7	dreg 2770'
12/14	8" 2885
	show oil 2952
	HF-W 2952-60
	dreg 3073'
12/21	Am 6" 3188
	Cong 3175-90
	Full big pipe

12/28- Top Cong 3202
show oil 3202-06
Pay 3222-25
TD 3230'

1500 ft oil 3 days
5" liner at 3200'
Kill down

1933

1/4- TD 3240'

3000 ft oil
No test

Ang tubing

1/11-

Cased 6"-3188

Cong. 3202-3240

Pay 3222-25

TD 3240

pump 114 bbl 1st 24 hr
Comp.

Rice

w

Map No. _____ Sec. 16 Twp. 19 R. 9

Well No. 1 Collis

Leban, Weaver & Texas Co. Company

Contractor

FIRST REPORTS


SECTION PLAT

_____ Ft. from N. Line

365 _____ Ft. from S. Line

_____ Ft. from E. Line

330 _____ Ft. from W. Line

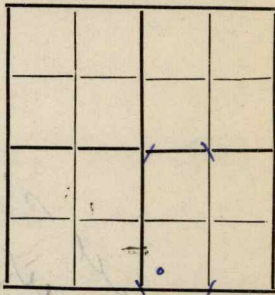

Location _____ ✓

Rig up _____

Drilling and Remarks:

RECORD

Cased _____ in., _____ ft.

Sand _____

Gas _____

Oil _____

Total Depth _____

PRODUCTION

1st 24 hrs. Nat. _____

1st 24 hrs. after shot _____

Gas _____ Cu. Ft.

Dry Hole _____

Abandoned _____

Date

OCT 5 1932

192

CHAS. L. SHERWOOD

Scout

49

KANSAS

Map No. 16 Sec. 16 Twp. 19 R. 9 ^WWell No. 1 CollisLebow, Weaver & Texas Company

Contractor

COMPLETED

SECTION PLAT

Ft. from N. Line

365 Ft. from S. Line

Ft. from E. Line

330 Ft. from W. Line

Location

Rig up

Drilling and Remarks:

Pay 3222.25Pump 114 Be
1st 24 hours

RECORD

Cased 6 in., 3188 ft.Sand ong 3202-3240

Gas

Oil

Total Depth 3240

PRODUCTION

1st 24 hrs. Nat.

1st 24 hrs. after shot

Gas Cu. Ft.

Dry Hole

Abandoned

Date

JAN 1 1 1933

19

CHAS. L. SHERWOOD

Scout