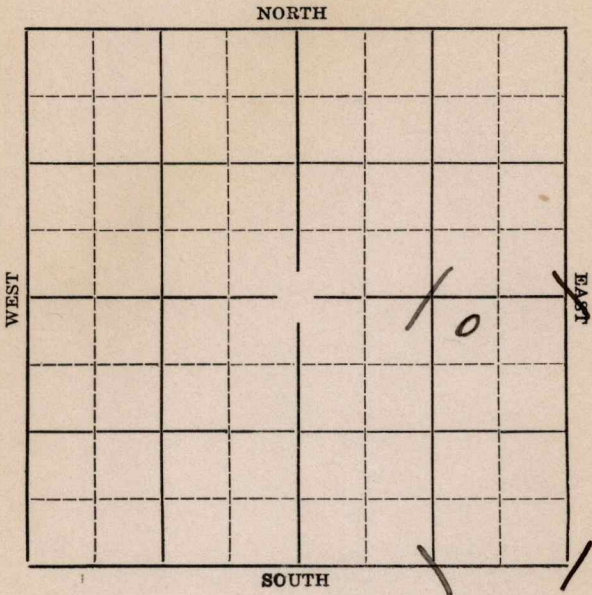


Section 16 Township 19 Range 9-WWell Number #1-CallisCompany ~~Stapleton et al~~ Shell


O. W. D. D

Sec. 16 Twp. 19 R. 9WWell No. #1 Callis Farm~~Stapleton et al~~ Shell Company330' Ft. from N. Line

Ft. from S. Line

990' Ft. from E. Line

Ft. from W. Line

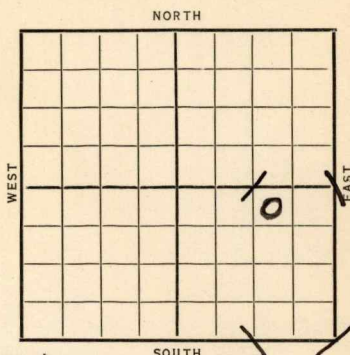

Texas farm out.

Date <u>1936</u>	Elev. <u>1695</u>	REPORT <u>O. W. D. D</u>
<u>9/23</u>	~~Texas farm out~~ Location.	
<u>10/1</u>	Rig.	
<u>10/8</u>	Rigging up.	
<u>10/15</u>	Spud.	
<u>10/22</u>	15" @ 319'. Drlg. 1840'.	
<u>10/29</u>	10" @ 1790'. 8 1/4" @ 2217'. Drlg. 2560'.	
<u>11/6</u>	³²³³ Sil ~~3179~~ 6" @ 3184 WOC	
<u>11/10</u>	Sil. 3233 Corrected	
	T. D. 3258 H. F. W. 3256	
	ABANDONED	
<u>1937</u>	O. W. D. L	
<u>2/17</u>	Old T. D. 3258'.	
	T. D. 3772'.	
	Salt water disposal well.	
	Will take 200 bbls water per hour.	
	FIRST REPORTS	
	<i>and</i>	
	ABANDONED	

KANSASMap No. 49 Sec. 16 Twp. 19 R. 9WWell No. 1 DallasStapleton & Dal. Company

Contractor

SECTION PLAT

			10

330 Ft. from N. Line

_____ Ft. from S. Line

990 Ft. from E. Line

_____ Ft. from W. Line

FIRST REPORTLocation ✓

Rig up _____

Drilling and Remarks:

Texas farm
out.**RECORD**

Cased _____ in., _____ ft.

Sand _____

Gas _____

Oil _____

Total Depth _____

PRODUCTION

1st 24 hrs. Nat. _____

1st 24 hrs. after shot _____

Gas _____ Cu. Ft.

Dry Hole _____

Abandoned _____

Date

SEP 23 1936

19

S. J. LEWIS

Scout

KANSASMap No. 49 Sec. 16 Twp. 19 R. 9WWell No. 1 CallinStapleton & Co Company

Contractor

SECTION PLAT

			0

330 Ft. from N. Line

_____ Ft. from S. Line

990 Ft. from E. Line

_____ Ft. from W. Line

ABANDONED

Location _____

Rig up _____

Drilling and Remarks:

Oil 32330 feetHF 4325-6.IT 47**RECORD**

Cased _____ in., _____ ft.

Sand _____

Gas _____

Oil _____

Total Depth 3238.**PRODUCTION**

1st 24 hrs. Nat. _____

1st 24 hrs. after shot _____

Gas _____ Cu. Ft.

Dry Hole _____

Abandoned _____

Date

NOV 10 1936 19

S. J. LEWIS Scout

Map No. 49 Sec. 16 Twp. 19 R. 9WWell No. 1 CallisShell U. P. & S. CompanyThis was the Stapleton Lease Contractor

SECTION PLAT

			0

330 Ft. from N. Line

_____ Ft. from S. Line

990 Ft. from E. Line

_____ Ft. from W. Line

FIRST REPORT
COMPLETEDDNDD

Location _____

Rig up _____

Drilling and Remarks:

Old 703258will take 200 gals
water per hr.Water disposal

RECORD

Cased _____ in., _____ ft.

Sand _____

Gas _____

Oil _____

Total Depth 3772

PRODUCTION

1st 24 hrs. Nat. _____

1st 24 hrs. after shot _____

Gas _____ Cu. Ft.

Dry Hole _____

Abandoned ☒

Date

FEB 17 1937 19

S. J. LEWIS Scout