


Rice

Section 16 Township 19 Range 9W

Well No. #2 Reese "C"

Company Shell etal.

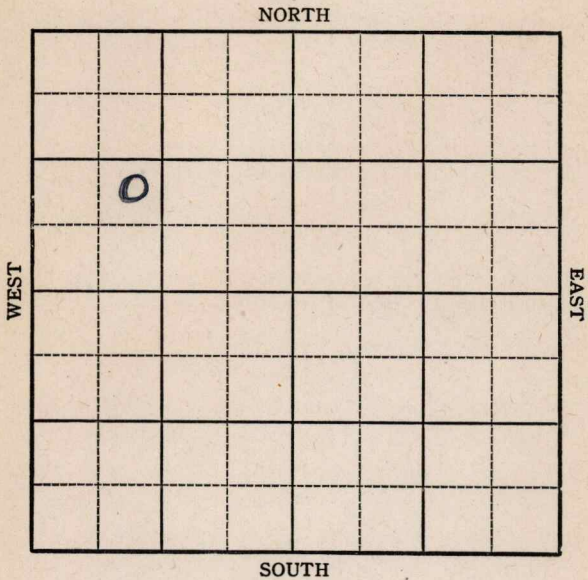

Sec. 16 Twp. 19 R. 9W

Well No. #2 Reese "C" Farm

Shell etal. Company

Chase Pool

NORTH


 Ft. from N. Line

990 Ft. from S. Line

 Ft. from E. Line

990 Ft. from W. Line

elev. 1698

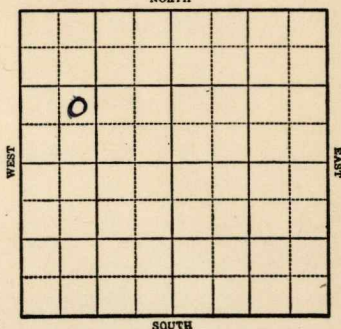

1944

R E P O R T

3/22	8" @ 218 2275'
3/29	Topeka 2460 Lans 2871 Cong. 3186 Dr1g. 3217
4/5	Arb 3223-28 TD Corrected 4" @ 3224 Rust
4/12	"
4/19	TD 3235 swb 2½ oil per hr.
4/26	TD 3237-1125' oil & 275' water in 17½ hrs.
5/3	" " "
5/10	" "
5/17	" "
5/24	" "
5/31	" "
6/7	" "
6/15	" "
6/21	" "

OVER

1944

6/28 TD 3237 1125' oil plus
275 wtr in 17 $\frac{1}{2}$ hrs

7/12 Arb 3223
4" @ 3224
300 Acid
Pump 37 oil plus 63 water Pot
Gravity 41.8
TD 3237

COMPLETED

Map No. 49 Sec. 16 Twp. 19 R. 9WWell No. 2 Reese "C"

Shell et al.

Company

FIRST REPORT

Contractor

NE SW NW

SECTION PLAT

0			

Ft. from N. Line

990

Ft. from S. Line

Ft. from E. Line

990

Ft. from W. Line

Chase Pool

Location

Rig up

Drilling and Remarks:

8" - 218

2275

RECORD

Cased _____ in., _____ ft.

Sand _____

Gas _____

Oil _____

Total Depth _____

PRODUCTION

1st 24 hrs. Nat. _____

1st 24 hrs. after shot _____

Gas _____ Cu. Ft.

Dry Hole _____

Abandoned _____

Date

MAR 22 1944

19

S. J. LEWIS Scout

KANSASPool Name ChaseMap No. 16 Sec. 16 Twp. 19 R. 9WWell No. 2 Reese "C"Shell et al. CompanyCOMPLETED Contractor

NE SW NW

SECTION PLAT

6			

990 Ft. from N. Line990 Ft. from S. Line990 Ft. from E. Line990 Ft. from W. LineRice County

Location _____

Rig up _____

Drilling and Remarks:

*Cr X 3223**4' 3224**3000 ad**Pump 37 oil**63 Water Pst**4/1 E*

RECORD

Cased _____ in., _____ ft.

Sand _____

Gas _____

Oil _____

Total Depth 3237

PRODUCTION

1st 24 hrs. Nat. _____

1st 24 hrs. after shot _____

Gas _____ Cu. Ft.

Dry Hole _____

Abandoned _____

Date

JUL 12 1944 19S. J. LEWIS Scout