


McPherson

KANSAS

SECTION 28 TOWNSHIP 19 RANGE 1W

WELL NO. #1 Doane "A"

COMPANY K & P

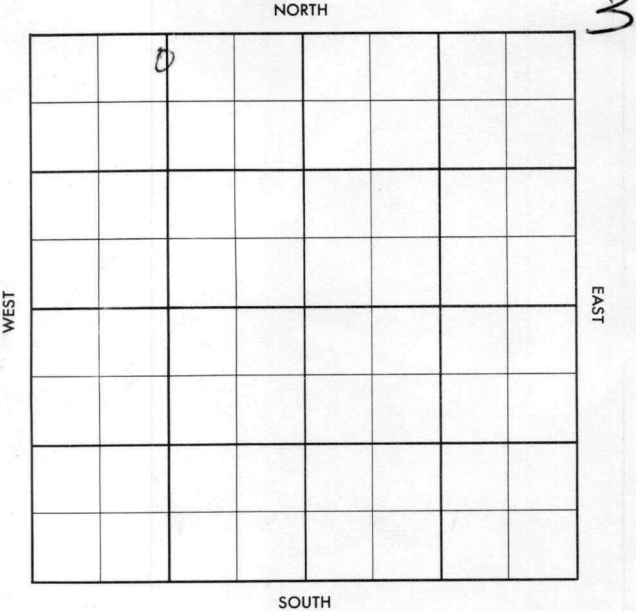

McPherson

KANSAS

SEC. 28	TWP. 19	R. 1W
------------	------------	----------

WELL NO.

#1 Doane "A"

FARM

COMPANY

K & P

CONTRACTOR

Mallard


Ritz-Canton

Ft. from N. Line

Ft. from S. Line

Ft. from E. Line

Ft. from W. Line

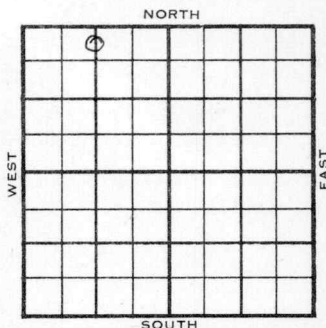C N $\frac{1}{2}$ N $\frac{1}{2}$ NW

1956

ELEVATION

1584 DF est.

REPORT

4-25

Comm. 4-18-56
 8" @ 155 w/105
 Drlg. 2700
 KC 2327

5-29

~~#####~~
~~#####~~

5 $\frac{1}{2}$ " @ 3390 w/125

DD 3393

S/ 13 BO / 600 BW 24 hrs., 650' O.B.

PB 3050, 256/2915-3015,

FU 1400' fluid, 8 hrs.

S/ 2 boph/ 3 bwph,

P/ 12 bo / 10 bw, 24 hrs.

M. 2919', V. 3390',

TD 3391'

COMPLETED

County McPherson Elev. _____
 Sec. 28 Twp. 19 Rge. 1W
 Company K & P
 Farm Name Doane "A" No. 1

TOPS	DEPTH	LOG	DATUM	Loc. in Sec.
Anh.				<u>C N$\frac{1}{2}$ N$\frac{1}{2}$ NW</u>
Tr.				
H.				
Tr.				
Dg.				
Bl.				
L.				
K.C.	<u>2327</u>			Geol. _____
B.K.C.				Contr. _____
Ce.				<u>Mallard</u>
C.				
M.				Pool _____
M.				<u>Ritz-Canton</u>
K.				
Mz.				
Mq.				
V.				
S.				
S.				
A.				
R.				
Pe.				
G.				
T.D.				

FIRST REPORT

APR 25 '56

Date Comm. 4-18-56
8" @ 155/105 drlg. 2700

MAILED
 MAY 5 1956

R.G.

County McPherson Elev. 1584 UF OST
 Sec. 28 Twp. 19 Rge. 1W
 Company K & P
 Farm Name Doane "A" No. 1

TOPS	DEPTH	LOG	DATUM	Loc. in Sec.
Anh.				C N $\frac{1}{2}$ N $\frac{1}{2}$ NW
Tp.				
H.				
Tr.				
Dg.				
Bl.				
L.				Geol.
K.C.	2327		443	
B.K.C.				Contr.
Ce.				Mallard
C.				
M.	2919		1335	Pool
M.				Ritz-Canton
K.				
Mz.				
Mq.				
V.	3390		1806	
S.				
S.				
A.				
R.				
Pe.				
G.				
T.D.	3391			

COMPLETE

Date Comm. 4-18-56 MAY 2 9 1956

8" @ 155/105 drlg. 2700 MAY 2 '56 5 1/2

@ 3390/125 MAY 9 '56 MAY 16 '56 CO

DD 3393 TB 4WL & 13 BO

+ 600 BW 24 hrs 650' O.B.

To PB MAY 23 '56 PB 3050 256/2915

- 3015 FU 1400' Fluid 8 hrs

& 2 Boph + 3 Bwph T & R

MAY 29 '56 P. 12 BO + 10 BW 24 hrs