FORM 51 5M 2-38 TPCO.


KANSAS

McPherson

Section 12 Township 21 Range 2-W

Well No. 1 Dicker Est.

Company Darrah,Aurrell & Williams

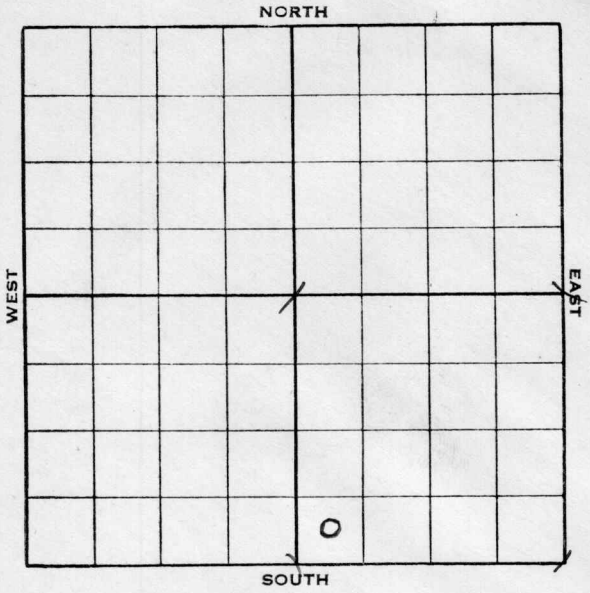


Form 252-A—5M—9-37 KANSAS McPherson

Sec. 12 Twp. 21 R. 2-W

Well No. #1 Decker Est. Farm

Darrah, Aurrell & Williams Company

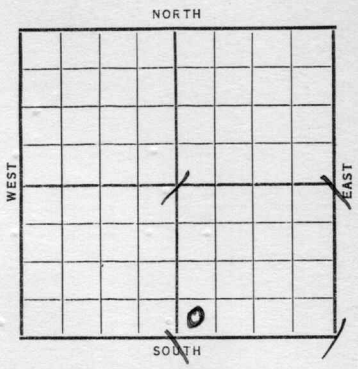

_____ Ft. from N. Line

330 Ft. from S. Line

_____ Ft. from E. Line

330 Ft. from W. Line

Elev. 1508'.

Date	REPORT
1938	
2/9	R U R
2/18	12" @ 116'. Drlg. 750'.
2/26	Howard 1670'. Lans. K. C. 2350'. Drlg. 2875'.
3/4	Cong. 2950'. Miss. 2985 T.D. 8" @ 2984'. RUST. No shows.
3/11	" " " " "
3/18	Miss. 2981' (Corrected) Est. 1 M gas 3004-05'. Sprayed oil 1 hr. Shut in for 15 hrs. 2600' fluid, 75% wtr. Flowed by heads. Killing gas. T.D. 3056'.
3/25	6" @ 3078'. H.F.W. 3080-85'. T.D. 3090'. U. R. 6".
4/1	6" @ 3086'. Base Miss. 3268'. Drlg. 3344'.
4/8	6" @ 3210'. Hunton 3350'. Viola 3440'. T.D. 3445'. U. R. 6". No shows.

OVER

1938

4/15 6" @ 3448'. Wilcox 3480-91'.
Drlg. 3535'.

4/22 Arb. 3557-62' S.W.
P. B. 2980'.

4/29 Drilled out to 3018'.
Est. 1 M gas.
Perforated 36 shots 3007-16'.
2000 acid.

5/6 Shut in.

5/12 " "

5/20 " "

5/25 6" @ 3448'.
Arb. 3557'.
T.D. 3562'.
P.B. 3018'.
Perf. 36 shots 3007-16'.
2000 acid.
Est. 5 M gas.

COMPLETED

Form 26—1M Bks.—2-29 McPherson KANSAS

Map No. 43 Sec. 12 Twp. 21 R. 2W,


Well No. 1 Decker Est.

Darrah, Aurrell & Williams Company

Contractor

FIRST REPORT

SECTION PLAT

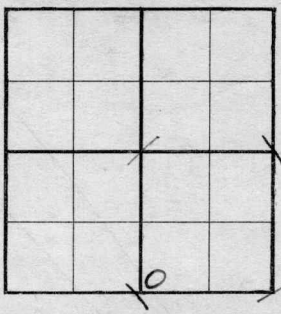

SW SE

Ft. from N. Line

330 Ft. from S. Line

Ft. from E. Line

330 Ft. from W. Line

Location

Rig up

Drilling and Remarks:

RUR

RECORD

Cased in., ft.

Sand

Gas

Oil

Total Depth

PRODUCTION

1st 24 hrs. Nat.

1st 24 hrs. after shot

Gas Cu. Ft.

Dry Hole

Abandoned

Date

FEB 9 1938 19

H. D. Hatfield Scout

Form 26—1M Bks.—2-29

McPherson KANSAS

Map No. 43 Sec. 12 Twp. 21 R. 2W

Well No. 1 Decker Est.

Darrah-Aurrell & Williams Company

Contractor

COMPLETED

SW SE


Ft. from N. Line

330 Ft. from S. Line

Ft. from E. Line

330 Ft. from W. Line

SECTION PLAT

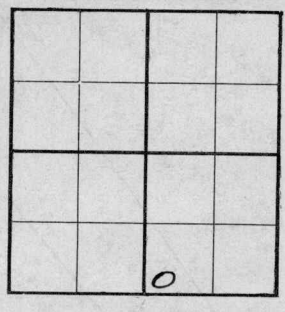

Location

Rig up

Drilling and Remarks:

P.B. 3018
Perf. 36 shots
3007-16
2000 Acid
Est 5 M. gas

RECORD

Cased 6 in., 3448 ft.

~~Sand~~ Arb 3557

Gas

Oil

Total Depth 3562

PRODUCTION

1st 24 hrs. Nat.

1st 24 hrs. after shot

Gas Cu. Ft.

Dry Hole

Abandoned

Date

MAY 25 1938 19

H. D. Hatfield Scout