


NORTH

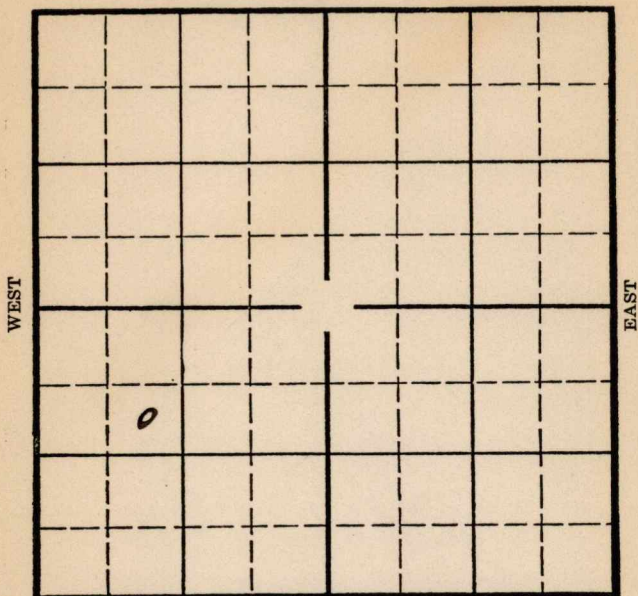

SOUTH

PRODUCTION

1st 24 hrs. Nat. _____

1st 24 hrs. after shot _____

Gas _____ cu. ft. _____

Dry Hole _____

Abandoned _____

KANSAS

Map No. _____ Sec. 16 Twp. 19 R. 9W

Well No. 3- Reese Farm _____

Natl Ref.

Company _____


990 Ft. from N. Line

_____ Ft. from S. Line

_____ Ft. from E. Line

990 Ft. from W. Line

Elev. 1697

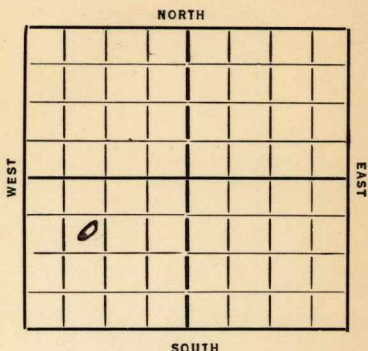

Date	REPORT
10/7	Rgw
10/10	dy 250
11/1	id 2185
11/7	" 2730 10" 2195
11/14	8" 2997
11/21	so 3188-91 6" 3185
11/29	Sil 3215-26 1600' Oil Tubg
12/1	pumped 208-24hrs
12/1	3 day avg will acidize
12/13	Acidized w/ 2000 Gal.
12/13	Pot test 136 Oil will deepen
12/19	TD 3236 500 acid
12/23	Sil 3215
	TD 3236
	500 acid
	208 Bbl.
	COMPLETED

KANSAS

Map No. 49 Sec. 16 Twp. 19 R. 9WWell No. 3- ReeseWalt Ref Company

Contractor


FIRST REPORTS

SECTION PLAT

990 Ft. from N. Line

.....Ft. from S. Line

.....Ft. from E. Line

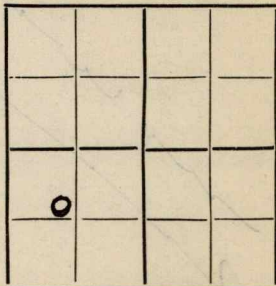990 Ft. from W. Line

Location.....

Rig up.....

Drilling and Remarks:

RECORD

Cased.....in.,ft.

Sand.....

Gas.....

Oil.....

Total Depth.....

PRODUCTION

1st 24 hrs. Nat.....

1st 24 hrs. after shot.....

Gas.....Cu. Ft.

Dry Hole.....

Abandoned.....

Date

10-2-35

192.....

ORVAL MANNSCHRECK

Scout

KANSAS

Map No. 49 Sec. 16 Twp. 19 R. 9WWell No. 3-ReeseNatl Refining Company

Contractor

COMPLETE

SECTION PLAT

990 Ft. from N. Line

Ft. from S. Line

Ft. from E. Line

990 Ft. from W. Line

Location

Rig up

Drilling and Remarks:

500 and208 bbls

RECORD

Cased _____ in. _____ ft.

Sand Sil 3215

Gas _____

Oil _____

Total Depth 3236

PRODUCTION

1st 24 hrs. Nat. _____

1st 24 hrs. after shot _____

Gas _____ Cu. Ft.

Dry Hole _____

Abandoned _____

Date

12-23-35 192. _____ Scout

ORVAL MANNSCHNECK