


Section 16 Township 19 Range 9W

Well No. #1 Sherman

Company E. K. Carey

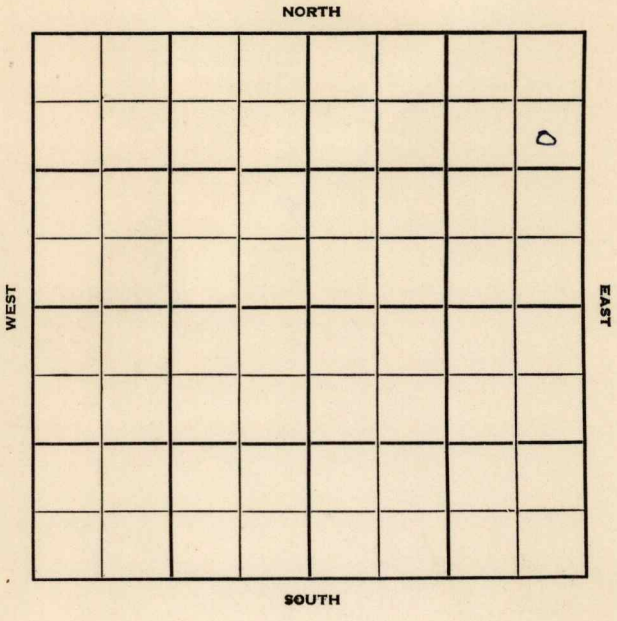

Rice

KANSAS

Sec. 16 Twp. 19 R. 9W

Well No. #1 Sherman Farm

E. K. Carey Company

Contractor


990' Ft. from N. Line

_____ Ft. from S. Line

330' Ft. from E. Line

_____ Ft. from W. Line

SE NE NE

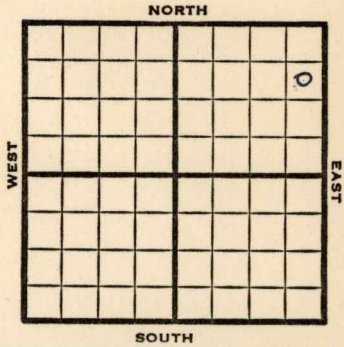

1952 **Elev. 1710'** REPORT

2/6 Spud 2-2-52
8" @
Drlg. 1404'

2/13 Drlg. 3047'

2/20 Heeb. 2719 Br Li 2846
Lans. 2875

DST 2890-2958 1 hr. 300' HGCM SO
312# Arb. 3203 TD 3207
5" @ 3204'

3/5 DD to 3219' S/1½ BOPH 500 A
No inc. DD

3/11 TD 3232' 2200' oil 12 hr.
S/ 7½ BOPH & trace wtr. POP

3/19 Spud 2-2-52
Oil Well TD 3232 8" @ 191
Heeb. 2719 Br Lime 2846
Lans. 2875
DST 2890-2958 opn 1 hr
Rec. 300' hgcm Arb. 3203
TD 3207 5" @ 3204 DD 3209
FU 50' oil 500 A S/1 boph 1500 A
DD 3219 S/1½ boph 500 A
DD 3232 FU 2200' oil 12 hrs.
S/7½ boph Comp. 150 bopd

COMPLETED

County Rice State Kansas

Sec. 16 (Blk.) 19 (Sur.) 9W Map No.

Operator E. K. Carey

Well No. 1 Farm Sherman

Elev. _____ Location SE NE NE

990 Ft. From N Line NE

330 Ft. From E Line Quarter

1st. Report FEB 6 1952

Completion _____

Remarks Shell - F.O.

Spudding Date 2-2-52

Drlg. Data

8" @ Drlg. 1404

J. G. McGEHEE

