Form 51—5M—1-30—38840


Rice

Map No. KANSAS Sec. 16 Twp. 19 R. 9W

Well No. 2 Sherman Farm

National Ref Company

NORTH

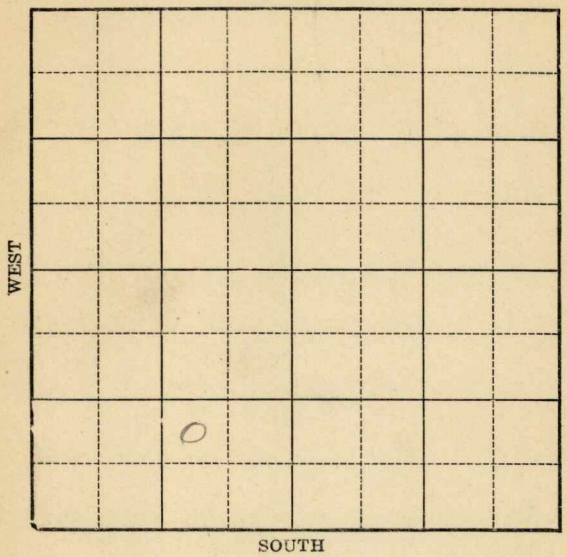

Location

Drilling Remarks

Rig Up

Drilling Remarks

RECORD

Cased in. ft.

Sand

Gas

Oil

Total Depth

PRODUCTION

1st 24 hrs. Nat.

1st 24 hrs. after shot

Gas cu. ft.

Dry Hole

Abandoned

Rice


Form 252-A
5M 4-32 MPC

KANSAS

Map No. _____ Sec. 16 Twp. 19 R. 9W

Well No. 2 – Sherman Farm

National Rfg Company

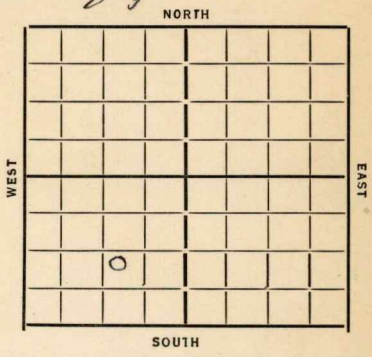

_____ Ft. from N. Line

990 Ft. from S. Line

990 Ft. from E. Line

_____ Ft. from W. Line

Date	REPORT
1933	
7/12	Bldg rig
7/19	Rig
7/26	45" 640 drlg 705
8/2	1505
8/9	13" – 1562 drlg 20 30'
8/17	drlg 2730
8/23	8" 3077' Co 3094
8/30	6" 3174 Top siliceous 3175 T.D. 3200'
9/6	Siliceous 3175
	T. D. 3200
	pump 370 bbls
1933	COMPLETED
9/20	O. W. D. D.
	Drilled T. D. 3211
	pump 450 bbls oil
	COMPLETED
~~1933~~	~~O W D D~~

Form 26—1M Bks.—9-26

KANSAS

Rice

Map No. ..... Sec. 16 Twp. 19 R. 9W


49

Well No. 2- Sherman

National Ref. Company

Contractor

SECTION PLAT

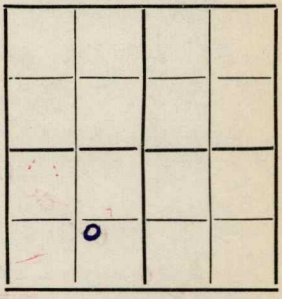

..... Ft. from N. Line

990 Ft. from S. Line

990 Ft. from E. Line

..... Ft. from W. Line

FIRST REPORTS

Location .....

Rig up .....

Drilling and Remarks:

BR

RECORD

Cased ..... in., ... ft.

Sand .....

Gas .....

Oil .....

Total Depth .....

PRODUCTION

1st 24 hrs. Nat. .....

1st 24 hrs. after shot .....

Gas ..... Cu. Ft.

Dry Hole .....

Abandoned .....

Date

7/12/33 192 Oval Mannuchs Scout

Form 26—1M Bks.—9-26

Ref


Map No. 49 Sec. 16 Twp. 19 R. 9W

Well No. 2 - Sherman

Nat'l Ref Company

Contractor

SECTION PLAT

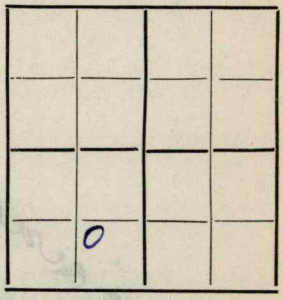

Ft. from N. Line

990 Ft. from S. Line

990 Ft. from E. Line

Ft. from W. Line

COMPLETED

Location

Rig up

Drilling and Remarks:

Pump 370

Hole

RECORD

Cased in., ft.

Sand Siliceous 3175

Gas

Oil

Total Depth 3200

PRODUCTION

1st 24 hrs. Nat.

1st 24 hrs. after shot

Gas Cu. Ft.

Dry Hole

Abandoned

Date

9/6/33 192 O. Mannuch Scout

Form 26—1M Bks.—9-28

Map No. 49 Sec. 16 Twp. 19 R. 9W

Well No. 2- Sherman

Nat'l Ref. Company

Contractor

not filed

SPECIAL

990 Ft. from N. Line

990 Ft. from S. Line

990 Ft. from E. Line

Ft. from W. Line

FIRST REPORTS & COMPLETED

SECTION PLAT



Location

Rig up

Drilling and Remarks:

O.T.D. 3200

Drilled to 3211

pump 450 bbls oil

RECORD

Cased in., ft.

Sand

Gas

Oil

Total Depth 3211

PRODUCTION

1st 24 hrs. Nat.

1st 24 hrs. after shot

Gas Cu. Ft.

Dry Hole

Abandoned

Date 7/20/33 192

D. Mannschreck Scout