


Map No. KANSAS Sec. 16 Twp. 19 R. 9W
Well No. 5 - Sherman Farm
National Ref. Company

 Ft. from N. Line

280 Ft. from S. Line

940 Ft. from E. Line

 Ft. from W. Line

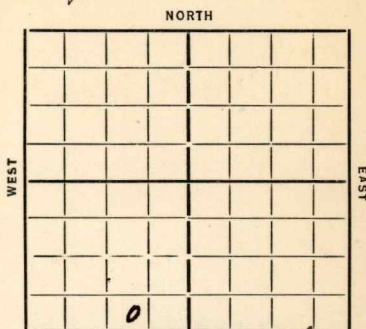

Shallow well ^{SOUTH} for Gas.

Date

REPORT

4/24	Location	
5/4	Rgn	
5/9	Spud	
5/16	dlg 710	15" 173
5/23	10" 707	59 1395 30 1535
5/29	8" 1596	6" 1720
	dlg 1800	
6/6	5" 1990	T 7 1992 5 1/4 m Gas
6/12	Gas	1987-1990
	T 7 1990	3 1/4 m Gas

COMPLETED

Map No. 49 Sec. 16 Twp. 19 R. 9w

Well No. 5-Sherman

National Ref Company

Contractor

FIRST REPORT

Main well

SECTION PLAT

Ft. from N. Line

280

Ft. from S. Line

940

Ft. from E. Line

Ft. from W. Line

Location ✓

Rig up

Drilling and Remarks:

Machine
shallow well
for gas

RECORD

Cased _____ in., _____ ft.

Sand _____

Gas _____

Oil _____

Total Depth _____

PRODUCTION

1st 24 hrs. Nat. _____

1st 24 hrs. after shot _____

Gas _____ Cu. Ft.

Dry Hole _____

Abandoned _____

Date

4-27-35

192

Scout

ORVAL MANNSCHRECK

Map No. 49 Sec. 16 Twp. 19 R. 9wWell No. 5 - ShermanNatl'l Refg Company

Contractor

COMPLETED

SECTION PLAT

Ft. from N. Line

280 Ft. from S. Line940 Ft. from E. Line

Ft. from W. Line

Location

Rig up

Drilling and Remarks:

3 1/4 m gas

RECORD

Cased _____ in., _____ ft.

Sand _____

Gas 1987-1990

Oil _____

Total Depth 1990

PRODUCTION

1st 24 hrs. Nat. _____

1st 24 hrs. after shot _____

Gas _____ Cu. Ft.

Dry Hole _____

Abandoned _____

Date

6-12-35

192

ORVAL MANN SCHRECK


Scout

Check Feet measurements
and location of
Well.

Sam

Sorry, now OK.

O.W.

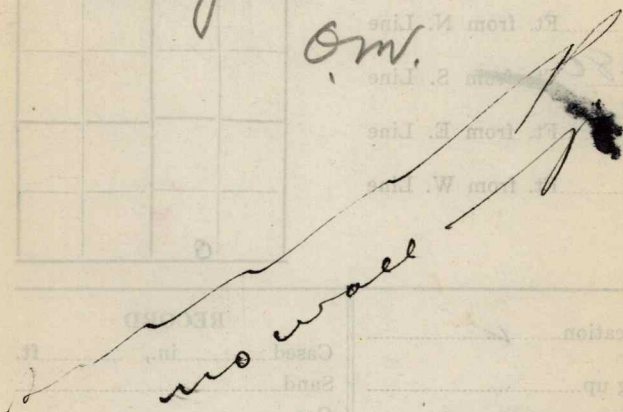

Returned

Cards

Tracing

France Map

Scarborough Map

Moody Map

Scarborough Plat Book

Moody Plat Book