


Rice
9W

Map No. KANSAS Sec. 16 Twp. 19 R. 9W

Well No. 7- Sherman Farm
National Ref. Company

330 Ft. from N. Line
 Ft. from S. Line
330 Ft. from E. Line
 Ft. from W. Line

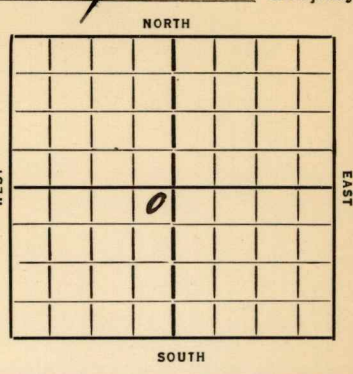

Elev. 1696

REPORT

1/29	Row up	
2/7	 	
2/14	Spuds	
2/21	SD 105	20" 80
2/28	alg 540	20" 145
3/6	" 1230	15" 753
3/13	" 1730	13" 1700
#3/20	Show gas 1975-80	10"-2173
	Drlg. 2250	
3/27	T. Lans 2845	Show oil 2896'
	4 million gas 2932	Drlg. 2928'
4/2	8"- 2921'	Drlg. 2950'.
4/10	6" @ 3179'	Sil. 3178' Show oil
4/16	Pay 3203'-08'	1200' oil 4½ hours.
4/23	Testing.	
4/29/36	Sil 3173'	
	Pay 3203-08'	T.D. 3208'
	Pump 270 Nat.	

COMPLETED

Map No. 49 Sec. 16 Twp. 19 R. 9W

Well No. 7-Sherman
National Ref. Company

Contractor

FIRST REPORTS

SECTION PLAT

330 Ft. from N. Line

..... Ft. from S. Line

330 Ft. from E. Line

..... Ft. from W. Line

	0		

Location.....

Rig up.....

Drilling and Remarks:

Rig up

RECORD

Cased.....in.,ft.

Sand.....

Gas.....

Oil.....

Total Depth.....

PRODUCTION

1st 24 hrs. Nat.....

1st 24 hrs. after shot.....

Gas.....Cu. Ft.

Dry Hole.....

Abandoned.....

Date

1-29-36 192.....

ORVAL MANNSCHRECK

Scout

KANSAS

Map No. 49 Sec. 16 Twp. 19 R. 9W

Well No. 7 Sherman

National Ref. Company

Contractor

SECTION PLAT

330 Ft. from N. Line

..... Ft. from S. Line

330 Ft. from E. Line

..... Ft. from W. Line

		0	

COMPLETED

Location.....

Rig up.....

Drilling and Remarks:

Sil 3173
Pay 3203-08
Pump 270 Nat

RECORD

Cased.....in.,ft.

Sand.....

Gas.....

Oil.....

Total Depth 3208

PRODUCTION

1st 24 hrs. Nat.....

1st 24 hrs. after shot.....

Gas.....Cu. Ft.

Dry Hole.....

Abandoned.....

Date

APR 29 1936

192.....

S. J. LEWIS

Scout

TOP Pool

O.W.W.O
Coastal Foot

S-513-B

County Rice Elev. 1696 DF
 Sec. 16 Twp. 19S Rge. 9W
 Company C. R. E.
 Farm Name Sherman No. 7

TOPS	DEPTH	LOG	DATUM
Anh.			
Tp.			
H.			
Tr.			
Dg.			
B.L.			
L. <u>K,</u>	<u>2845</u>		
K.C.			
B.K.C.			
Ce.			
C.	<u>3147</u>		
M.			
M.			
K.			
Mz.			
Mq.			
V.			
S.			
S.			
A.	<u>3173</u>		
R.			
Pf.			
G.			
T.D.			

Loc. in Sec. NE NE SW
(O.W.W.O)
 Geol. O.W.W.O.
 Contr. _____
 Pool Chase-Silica

**FIRST REPORT
 COMPLETE**
 0
 AUG 27 58

Date Comm. OTD 3208, 7" @ 3179, Arb well Comp
4-17-36, PB to ? CO to ? 32/2942-50, 40/2924-
34, 4/2914-15, 28/2876-83, 24/2862-68,
1500A, POP, P 7 BO / 58 BW/24 hrs, Complete
LK Perfs.