


Section 16 Township 19 Range 9-W

Well No. #2 Sherman "A"

Company Shell

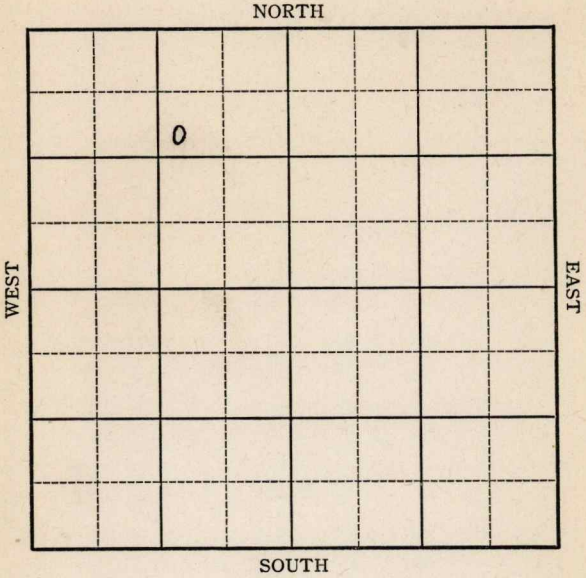

KANSAS

Rice

Sec. 16 Twp. 19 R. 9-W

Well No. #2 Sherman "A" Farm

Shell Company

Chase


991 Ft. from N. Line

_____ Ft. from S. Line

997 Ft. from E. Line

_____ Ft. from W. Line

Elev. 1699

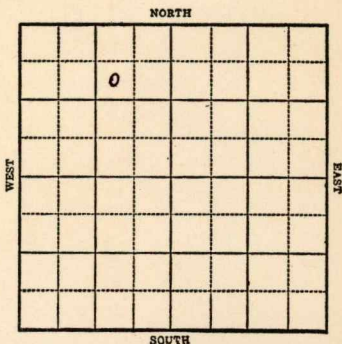

1943

R E P O R T

6/23

Location.

6/30

8" @ 173'

Drlg. 2068'

7/7

Topeka 2467

Ans 2870

Arb 3194

T. D. 3200

4 @ 3196' Rust

7/15

T.D. 3212-1000 acid
swab 200 oil in 5 hrs.

7/21

Arb. 3194

4" @ 3196

T.D. 3212'

1000 acid

Depth Pot 1853

Gravity 41.7

COMPLETED

KANSAS

Rice

Map No. 49 Sec. 16 Twp. 19 R. 9W

Well No. 2 Sherman "A"

Shell

Company

FIRST REPORT

Contractor

SW NE NW

SECTION PLAT

991 Ft. from N. Line

	o		

_____ Ft. from S. Line

997 Ft. from E. Line

_____ Ft. from W. Line

CHASE POOL

Location XXX

RECORD

Rig up _____

Cased _____ in., _____ ft.

Drilling and Remarks:

Sand _____

Gas _____

Oil _____

Total Depth _____

PRODUCTION

• 1st 24 hrs. Nat. _____

1st 24 hrs. after shot _____

Gas _____ Cu. Ft.

Dry Hole _____

Abandoned _____

Date

JUN 23 1943 19

S. J. LEWIS Scout

Rice

KANSAS

Map No. 79 Sec. 16 Twp. 19 R. 9W

Well No. 2 Sherman "A"

Shell Company

COMPLETED

Contractor

SECTION PLAT

SW NE NW

991 Ft. from N. Line

_____ Ft. from S. Line

997 Ft. from E. Line

_____ Ft. from W. Line

	0		

CHASE POOL

Location _____

Rig up _____

Drilling and Remarks:

Cor 8 3194
4" @ 3196
1000 acid
Sept to Oct 1953

412/44

RECORD

Cased _____ in., _____ ft.

Sand _____

Gas _____

Oil _____

Total Depth 3212

PRODUCTION

1st 24 hrs. Nat. _____

1st 24 hrs. after shot _____

Gas _____ Cu. Ft.

Dry Hole _____

Abandoned _____

Date

JUL 21 1943 19

S. J. LEWIS Scout