

Map No. **KANSAS** Sec. **16** Twp. **19** R. **9-W**
Well No. **1-Sherman "B"** Farm
Shell Company

NORTH

WEST

EAST

SOUTH

Location _____

Drilling Remarks

Rig Up

Drilling Remarks

RECORD

Cased..... in..... ft.

Sand

Gas

Oil.....

Total Depth_____

PRODUCTION

1st 24 hrs. Nat.

1st 24 hrs. after shot.....

Gas _____ cu. ft.

Dry Hole

Abandoned

Map No. _____ Sec. 16 Twp. 19 R. 9WWell No. #1 Sherman "B" Farm _____Shell

Company _____

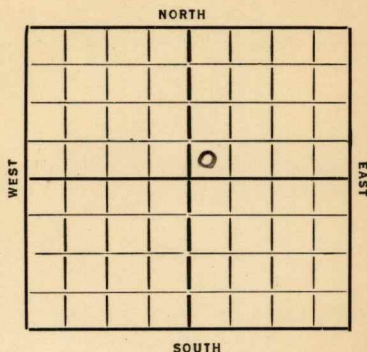
_____ Ft. from N. Line

330' _____ Ft. from S. Line

_____ Ft. from E. Line

330' _____ Ft. from W. Line

Elev. 1694

Date
1936

REPORT

4/29 Rig.5/7 12" @ 175'. W.O.C.5/14 Drlg. 15858.5/21 Drlg. 2570'.5/28 K.C. 2865'. S.O. 2875'-80'. Drlg. 3030'.6/4 Sil. 3193'. T.D. 3198'.6/11 Pay 3205-10'. T.D. 3218'. Swabbing 20 bbls oil per hour.6/17/36-Sil. 3193'.

T.D. 3226'.

Potential 1301 bbls oil and 20 bbls water.

COMPLETED

KANSAS

Map No. 49 Sec. 16 Twp. 19 R. 9WWell No. 1 Sherman "B"Shell Company

Contractor

SECTION PLAT

		0	

Ft. from N. Line

330 Ft. from S. Line

Ft. from E. Line

330 Ft. from W. Line

FIRST REPORT

RECORD

Location

Cased in, ft.

Rig up

Sand

Drilling and Remarks:

Gas

Oil

Total Depth

PRODUCTION

1st 24 hrs. Nat.

1st 24 hrs. after shot

Gas Cu. Ft.

Dry Hole

Abandoned

Date

APR 29 1936

192

S. J. LEWIS

Scout

Map No. 49 Sec. 16 Twp. 19 R. 9W **KANSAS**Well No. Sherman BShell. Company

Contractor

SECTION PLAT

		0	

_____ Ft. from N. Line

330 Ft. from S. Line

_____ Ft. from E. Line

330 Ft. from W. Line

COMPLETED

Location _____

Rig up _____

Drilling and Remarks:

Oil 3193.Prod 1301 oil
20 Water

RECORD

Cased _____ in., _____ ft.

Sand _____

Gas _____

Oil _____

Total Depth 3226.

PRODUCTION

1st 24 hrs. Nat. _____

1st 24 hrs. after shot _____

Gas _____ Cu. Ft.

Dry Hole _____

Abandoned _____

Date

JUN 17 1936 19

Scout

S. J. LEWIS