


Section 4 Township 18 Range 14W

Well No. #2, Robert Monroe


Company Continental & Phillips

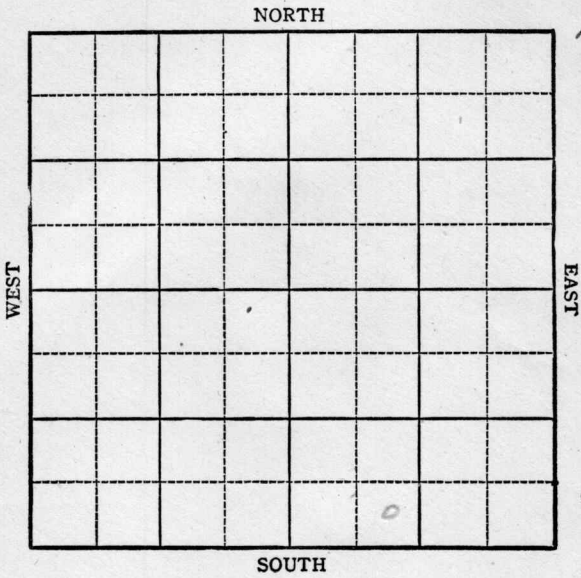

Sec. 4 Twp. 18 R. 14W

Well No. #2, Robert Monroe Farm
Continental & Phillips Company

NORTH

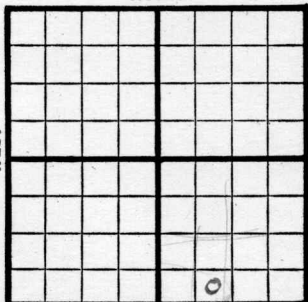

 Ft. from N. Line

330 Ft. from S. Line

 Ft. from E. Line

990 Ft. from W. Line

SE SW SE Elev. 1966

SOUTH

1944

REPORT

6/7	Location
6/15	Surface Hole.
6/21	13" @ 249 8" @ 932 WOC
6/28	2320 Fishing
7/12	Lans 3210 Cong 3422 Arb 3439-41 TD 6" @ 3440 RUST
7/26	TD 3456-2000 acid swb. 43½ oil PH 4hrs
8/9	Arb. 3439 6" @ 3440 2000 acid Pump 1214 Pot. Grav. 37.0 TD 3456

COMPLETED

KANSAS

Pool Name Boyd

Map No. 73 Sec. 4 Twp. 18 R. 14W

Well No. 2 Robert Monroe

Continental & Phillips Company

FIRST REPORT

Contractor

SE SW SE

SECTION PLAT

_____ Ft. from N. Line

330 Ft. from S. Line

_____ Ft. from E. Line

990 Ft. from W. Line

Barton County

Location X

Rig up _____

Drilling and Remarks:

RECORD

Cased _____ in., _____ ft.

Sand _____

Gas _____

Oil _____

Total Depth _____

PRODUCTION

1st 24 hrs. Nat. _____

1st 24 hrs. after shot _____

Gas _____ Cu. Ft.

Dry Hole _____

Abandoned _____

Date

JUN 7 1944

S. J. LEWIS

Scout

