Rice


FORM 51 5M 4-41 PETROL

KANSAS

Section 18 Township 19 Range 9W

Well No. 1 Kate

Company Phillips Petroleum

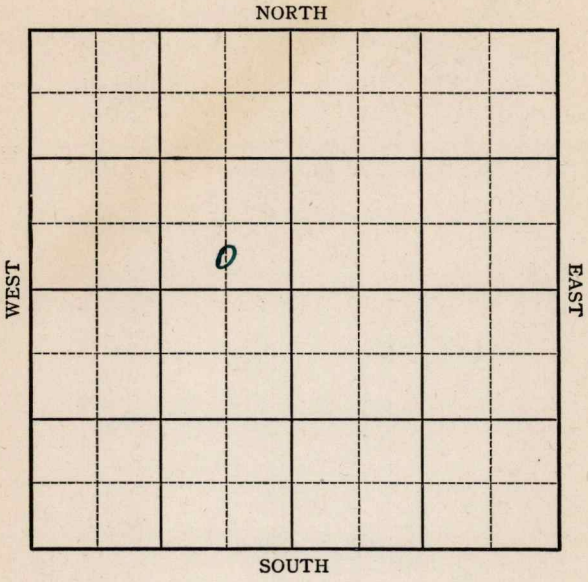

FORM 252-A 5M 6-41 PETROL KANSAS Rice

Sec. 18 Twp. 19 R. 9-W

Well No. #1 Kate Farm

Phillips Petr. Company


(Chase)

____ Ft. from N. Line

330 Ft. from S. Line

660 Ft. from E. Line

____ Ft. from W. Line

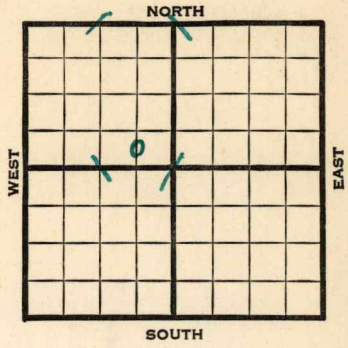

Elev. 1741

1941	REPORT
7/16	Location
7/24	8" @ 259 WOC
7/31	Drlg. 2712'
8/7	Lansing 2921 Arb 3268-70 TD
	5" @ 3268 RUST
8/15	Drlg. to 3273½
	SSO & Wtr.
8/21	T.D. 3276' 500 acid.
	Testing.
8/28	"
9/4	Pump 35 oil in 8 hours.
9/10	Arb. 3268'
	5" - 3268'
	T.D. 3276'
	500 acid.
	Potential 133 bbls., pump.
	42.6 Gravity
	COMPLETED

Form 26 200 Bks. 5-41 McW. Rice KANSAS

Map No. 49 Sec. 18 Twp. 19 R. 9W

Well No. 1 Kate

Phillips Petroleum Company

Contractor

FIRST REPORT

C S L SE NW

____ Ft. from N. Line


330 Ft. from S. Line

660 Ft. from E. Line

____ Ft. from W. Line

CHASE POOL

SECTION PLAT

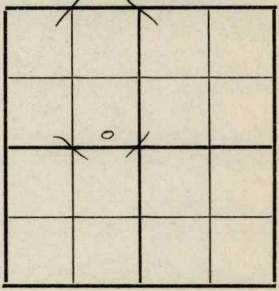

Location X

Rig up

Drilling and Remarks:

RECORD

Cased ____ in., ____ ft.

Sand

Gas

Oil

Total Depth

PRODUCTION

1st 24 hrs. Nat.

1st 24 hrs. after shot

Gas ____ Cu. Ft.

Dry Hole

Abandoned

Date

JUL 16 1941 19 S. J. LEWIS Scout

Form 26 200 Bks. 5-41 McW. Rice KANSAS

Map No. _____ Sec. 18 Twp. 19 R. 9W

Well No. 1 Kate

Phillips Company

Contractor

COMPLETED

C S L SE NW

_____ Ft. from N. Line


330 Ft. from S. Line

660 Ft. from E. Line

_____ Ft. from W. Line

CHASE POOL

SECTION PLAT

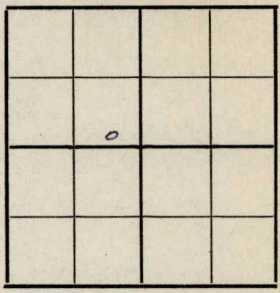

Location _____

Rig up _____

Drilling and Remarks:

Cr @ 3268.
5" @ 3268.
500 acid
Pump 133 Bbl.

42 6 Gr.

RECORD

Cased _____ in., _____ ft.

Sand _____

Gas _____

Oil _____

Total Depth 3276

PRODUCTION

1st 24 hrs. Nat. _____

1st 24 hrs. after shot _____

Gas _____ Cu. Ft.

Dry Hole _____

Abandoned _____

Date

SEP 10 1941 19

S. J. LEWIS Scout