


Section 17 Township 19 Range 9W

Well No. 1 Proffitt

Company Lario Oil & Gas

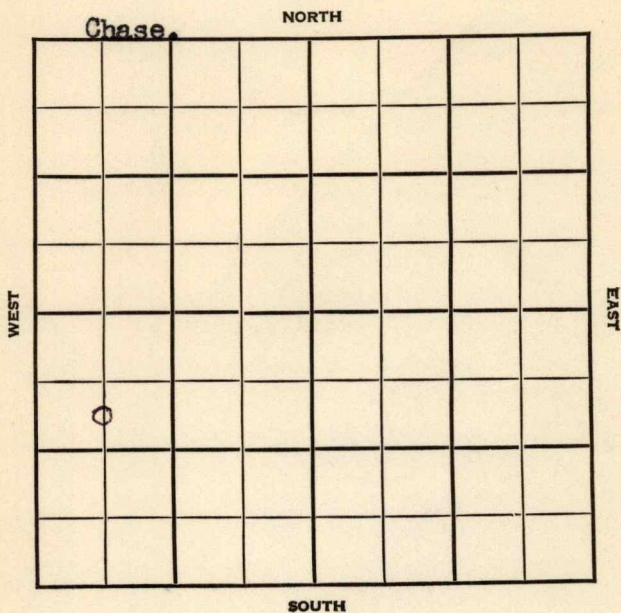

Sec. 17 Twp. 19 R. 9W

Well No. #1 Proffitt Farm

Lario Oil & Gas Company
Chase


990 Ft. from N. Line

Ft. from S. Line

Ft. from E. Line

660 Ft. from W. Line

C S L NW SW

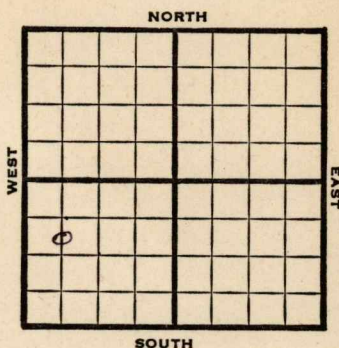

1948 **Elev. 1726'** **REPORT**

2/25 Surface hole.

3/3 Drlg. 2670'

3/10 8" @ 193'
Lansing 2904'
Quartzite 3254'
TD 3263'
5" @ 3256'
RUST

3/17 "

3/24 "

3/31 "

4/7 PB 2998'
8 shots 2983-85'
Swb $1\frac{1}{2}$ bbls. oil / 34 W

4/14 "

4/21 "

4/28 **Cong. 3237'**
5" @ 3256'
TD 3302'

ABANDONED

Map No. _____ Sec. 17 Twp. 19 R. 9W

Well No. 1 Proffitt

Lario Oil & Gas Company

FIRST REPORT

Contractor

C S L NW SW


SECTION PLAT

990 Ft. from N. Line

220 Ft. from S. Line

_____ Ft. from E. Line

660 Ft. from W. Line

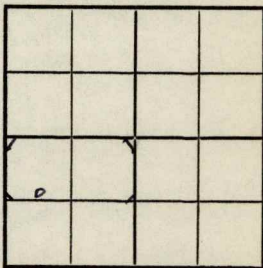

Rice County

Location _____

Rig up _____

Drilling and Remarks:

surface hole

RECORD

Cased _____ in., _____ ft.

Sand _____

Gas _____

Oil _____

Total Depth _____

PRODUCTION

1st 24 hrs. Nat. _____

1st 24 hrs. after shot _____

Gas _____ Cu. Ft.

Dry Hole _____

Abandoned _____

Date

FEB 25 1948 19 S. J. LEWIS Scout

Map No. 49 Sec. 17 Twp. 19 R. 9W

Well No. 1 Proffitt

Lario Oil & Gas Company

ABANDONED

Contractor

C S L NW SW

E11726
SECTION PLAT

990 SB. Ft. from N. Line

990 Ft. from S. Line

Ft. from E. Line

660 Ft. from W. Line

Rice County

Location _____

Rig up _____

Drilling and Remarks:

Core 3237
S. 3206

RECORD

Cased ☒ in., _____ ft.

Sand _____

Gas _____

Oil _____

Total Depth 3302

PRODUCTION

1st 24 hrs. Nat. _____

1st 24 hrs. after shot _____

Gas _____ Cu. Ft.

Dry Hole _____

Abandoned _____

Date

APR 28 1948

19

S. J. LEWIS

Scout


Map No. _____ Sec. _____ Twp. _____ R. _____

Well No. check spot +

Thompson
FIRST REPORT

Contractor _____

SECTION PLAT

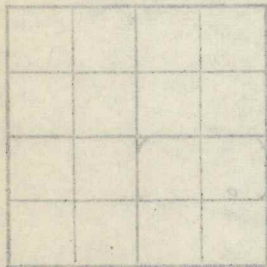

990 Ft. from N. line

Ft. from S. line

Ft. from E. line

660 Ft. from W. line

Rice County

RECORD

Cased _____ in _____ ft.
Sand _____
Gas _____
Oil _____
Total Depth _____

Location _____
Rig up _____
Drilling and Remarks: _____

surface hole

Misc. Small Maps _____
Cards Ruth
Tracing _____
France Map _____
Scarborough Map _____
Pierce Map _____
Geological Dept. _____
Book _____

Date _____

FEB 25 1948