

KANSAS

Rice

Form 51—5M—7-40—Palace

Section 21 Township 20 Range 9-W


Well No. 1 Dick

Company Derby & Lario

NORTH

Keesling Pool

WEST

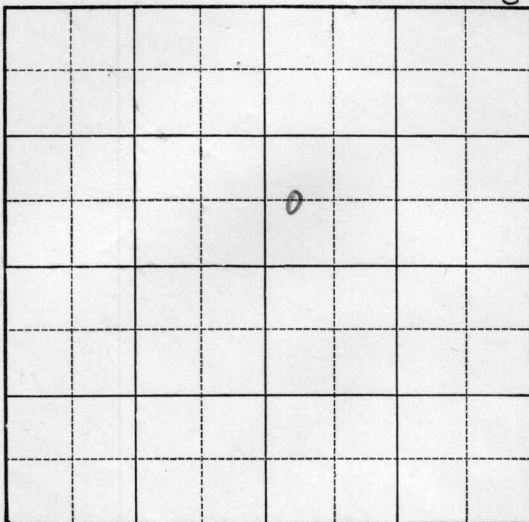


EAST

SOUTH

Map No. 49 Sec. 21 Twp. 20 R. 9WWell No. 1 DickDerby & Lario CompanyFIRST REPORT Contractor

SECTION PLAT

C W L SW NE

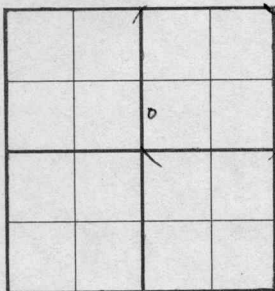 Ft. from N. Line660 Ft. from S. Line Ft. from E. Line330 Ft. from W. Line

KEESLING POOL

Location XRig up

Drilling and Remarks:

RECORD

Cased in., ft.Sand Gas Oil Total Depth

PRODUCTION

1st 24 hrs. Nat. 1st 24 hrs. after shot Gas Cu. Ft.Dry Hole Abandoned

Date

FEB 19 1941 19S. J. LEWIS

Scout

