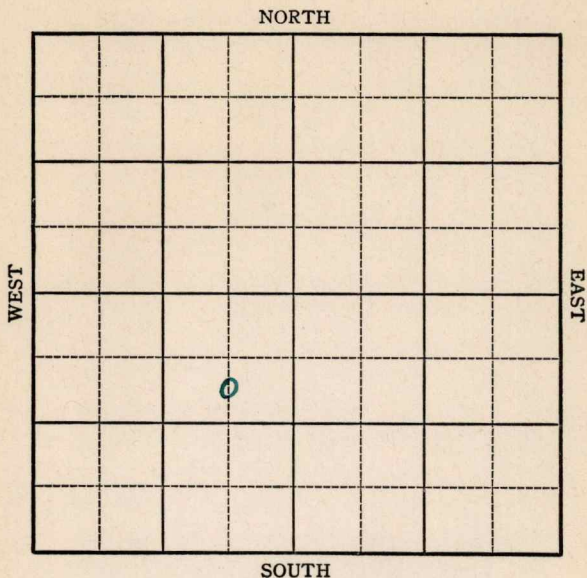


Rice

KANSAS

Section 18 Township 19 Range 9-WWell No. #2 LinkCompany C. H. Weaver

KANSAS

Map No. 17.49 Sec. 18 Twp. 19 R. 9WWell No. 2 LinkC. H. Weaver CompanyFIRST REPORT Contractor

C SL NE SW

SECTION PLAT

	o		

990 Ft. from N. Line Ft. from S. Line660 Ft. from E. Line Ft. from W. Line

CHASE POOL

Location Rig up

Drilling and Remarks:

8" - 136'

Drlg. 200'

RECORD

Cased in., ft.Sand Gas Oil Total Depth

PRODUCTION

1st 24 hrs. Nat. 1st 24 hrs. after shot Gas Cu. Ft.Dry Hole Abandoned

Date

NOV 25 1941

19

S. J. LEWIS Scout

Rice

KANSAS

Map No. 49 Sec. 18 Twp. 19 R. 9WWell No. 2 LinkC. H. Weaver CompanyABANDONED Contractor

C SL NE SW

990 Ft. from N. Line Ft. from S. Line660 Ft. from E. Line Ft. from W. Line

SECTION PLAT

CHASE POOL

Location Rig up

Drilling and Remarks:

Ar 73297No show

RECORD

Cased in., ft.Sand Gas Oil Total Depth 335

PRODUCTION

1st 24 hrs. Nat. 1st 24 hrs. after shot Gas Cu. Ft.Dry Hole Abandoned

Date

DEC 17 1941 19

S. J. LEWIS

Scout