McPherson


FORM 51 5M 1-42 PETROL

KANSAS

Section 13 Township 21 Range 2W

Well No. #1 Rupp

Company J.B. Allison etal.

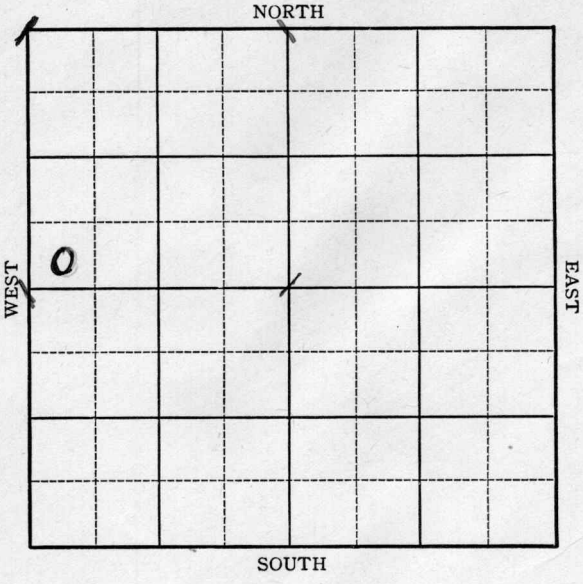

FORM 252-A
5M 9-43 GASS

KANSAS

McPherson

Sec. 13 Twp. 21 R. 2W

Well No. #1 Rupp Farm

J.B. Allison etal. Company


Wildcat

_____ Ft. from N. Line

330 Ft. from S. Line

_____ Ft. from E. Line

330 Ft. from W. Line

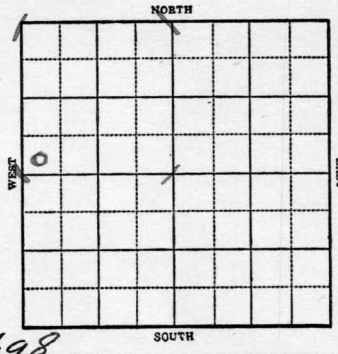

Elev. 1498

1944	REPORT
3/1	10" @ 149' TD 2340'
3/8	Miss 2958 Drilling 3110'
3/16	Misener 330 Hunton 3338 Viola 3417-19 TD 5" @ 3419 Rust
3/22	TD 3427 No shows 15 shots 3330-45 no shows 30 shots 2960-90 HFW SD
3/29	"
4/5	"
4/12	Squeeze perf. 2960-90
4/19	5" @ 3419 Viola 3417 TD 3427 Water

ABANDONED

Form 26 200 Bks 5-42 Petrol McPherson

KANSAS

Map No. 43 Sec. 13 Twp. 21 R. 2W

Well No. 1 Rupp


J. B. Allison etal, Company

FIRST REPORT

Contractor

SW NW

SECTION PLAT

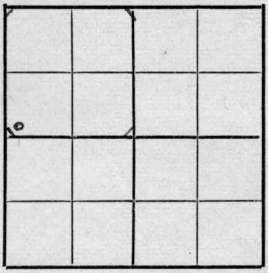

____ Ft. from N. Line

330 Ft. from S. Line

____ Ft. from E. Line

330 Ft. from W. Line

Wildcat

Location

Rig up

Drilling and Remarks:

10" - 149

2340

RECORD

Cased ____ in., ____ ft.

Sand

Gas

Oil

Total Depth

PRODUCTION

1st 24 hrs. Nat.

1st 24 hrs. after shot

Gas ____ Cu. Ft.

Dry Hole

Abandoned

Date

MAR 1 1944 19

S. J. LEWIS Scout

FORM 26 200 BKS. 2-44 PETROL

Pool Name Wildcat

KANSAS

Map No. 4-3 Sec. 13 Twp. 21 R. 2W


Well No. 1 Rupp

J. B. Allison etal. Company

ABANDONED Contractor

SW NW

SECTION PLAT

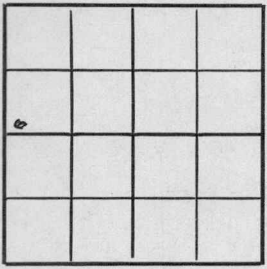

____ Ft. from N. Line

330 Ft. from S. Line

____ Ft. from E. Line

330 Ft. from W. Line

McPherson County

Location

Rig up

Drilling and Remarks:

Vis to 3417

5" to 3417

Water.

RECORD

Cased ____ in., ____ ft.

Sand

Gas

Oil

Total Depth 3427

PRODUCTION

1st 24 hrs. Nat.

1st 24 hrs. after shot

Gas ____ Cu. Ft.

Dry Hole

Abandoned

Date

APR 19 1944 19 S. J. LEWIS Scout