

Rice


KANSAS

Form 51—5M—4-36—Palace

Section 18 Township 19 Range 9-W

Well Number #1 Murphy

Company Gulf

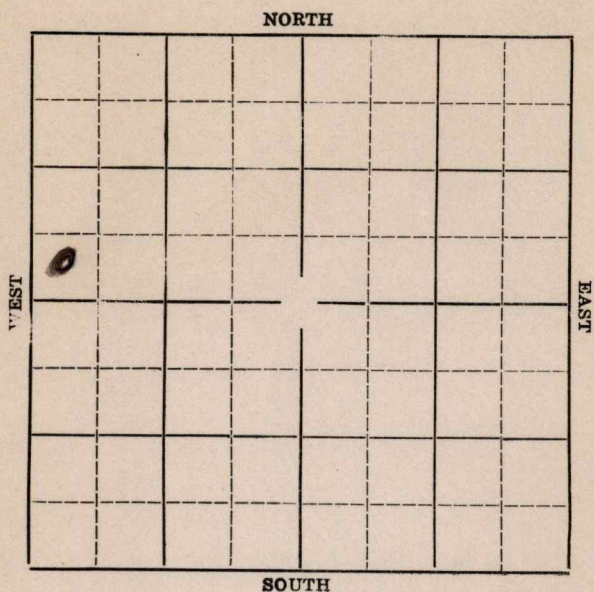

Sec. 18 Twp. 19 R. 9-W

Well No. 1 Murphy Farm

Gulf _____ Company


_____Ft. from N. Line

330 Ft. from S. Line

Ft. from E. Line

330 Ft. from W. Line

Elev. 1747

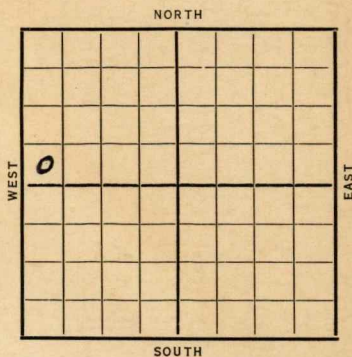

Date	REPORT
11/4	Building Rig
11/12	Drlg. 1300
11/19	Drlg. 2890'.
11/27	Sil. 3272'. 6" @ 3286'. T. D. 3288'. Rust.
12/3	3304', 250' fluid. 40' is oil
12/10	T. D. 3304'. P.B. 3301'.
12/17	Shot 10 qts. 3294-3301'.
12/24	1000 acid. Swabbed 2 bbls. oil 8 water 14 hours.
12/29	1000 acid. shot 20 qts. Clean out.
1937	
1/7	800' water 8 hrs.
	OVER

1937

1/13 Sil. 3272'. T. D. 3304'.
Shot 10 qts. 3294-3301'.
1000 acid. Shot 20 qts.
Water.

ABANDONED

KANSASMap No. 49 Sec. 18 Twp. 19 R. 9WWell No. 1 MurphyGulf. Company

Contractor

SECTION PLAT

0			

_____ Ft. from N. Line

320 Ft. from S. Line

_____ Ft. from E. Line

320 Ft. from W. Line**FIRST REPORT**

Location _____

Rig up _____

Drilling and Remarks:

Building rig**RECORD**

Cased _____ in., _____ ft.

Sand _____

Gas _____

Oil _____

Total Depth _____

PRODUCTION

1st 24 hrs. Nat. _____

1st 24 hrs. after shot _____

Gas _____ Cu. Ft.

Dry Hole _____

Abandoned _____

Date

NOV 4 1936

19

S. J. LEWIS

Scout

KANSASMap No. 49 Sec. 18 Twp. 19 R. 9WWell No. 1 Murphy

Company

Contractor

SECTION PLAT

0			

 Ft. from N. Line330 Ft. from S. Line Ft. from E. Line330 Ft. from W. Line

ABANDONED

Location Rig up

Drilling and Remarks:

Sic 3272Blw 8109 to 8294-32011000 acidBlw 8209 towaterD & H**RECORD**Cased in., ft.Sand Gas Oil Total Depth 3304**PRODUCTION**1st 24 hrs. Nat. 1st 24 hrs. after shot Gas Cu. Ft.Dry Hole Abandoned

Date

JAN 13 1937

19

S. J. LEWIS

Scout