


Section 18 Township 19 Range 9-W

Well Number #1 Wilcox


Company Ohio Oil

NORTH **SPECIAL**

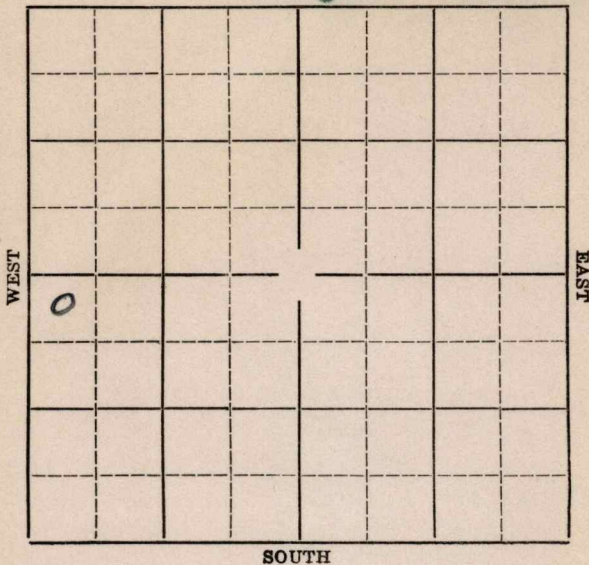

Ohio Oil Co. _____ Company

330' Ft. from W. Line

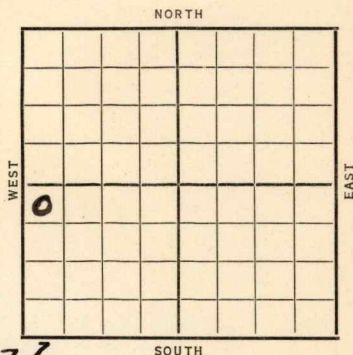

Special

COMPLETED

KANSAS

Map No. 49 Sec. 18 Twp. 19 R. 9W

Well No. 1 Hilcon

Ohio Oil Company

Contractor

Special

SECTION PLAT

0			

330 Ft. from N. Line

_____ Ft. from S. Line

_____ Ft. from E. Line

330 Ft. from W. Line

FIRST REPORT

Location ✓

Rig up _____

Drilling and Remarks:

RECORD

Cased _____ in., _____ ft.

Sand _____

Gas _____

Oil _____

Total Depth _____

PRODUCTION

1st 24 hrs. Nat. _____

1st 24 hrs. after shot _____

Gas _____ Cu. Ft.

Dry Hole _____

Abandoned _____

Date ○

OCT 21 1936 19

S. J. LEWIS

Scout

KANSASMap No. 49 Sec. 18 Twp. 19 R. 9WWell No. WilcoxOhio Company

Contractor

SECTION PLAT

0			

330 Ft. from N. Line

_____ Ft. from S. Line

_____ Ft. from E. Line

330 Ft. from W. Line**COMPLETED**

Location _____

Rig up _____

Drilling and Remarks:

Oil 8266 @ directed2000 acidP-81144**RECORD**

Cased _____ in., _____ ft.

Sand _____

Gas _____

Oil _____

Total Depth 8283**PRODUCTION**

1st 24 hrs. Nat. _____

1st 24 hrs. after shot _____

Gas _____ Cu. Ft.

Dry Hole _____

Abandoned _____

Date

DEC 22 1936

19

S. J. LEWIS Scout