


Rice **KANSAS**

Section 18 Township 19 Range 9W

Well No. 14 Kate

Company Phillips Petr.

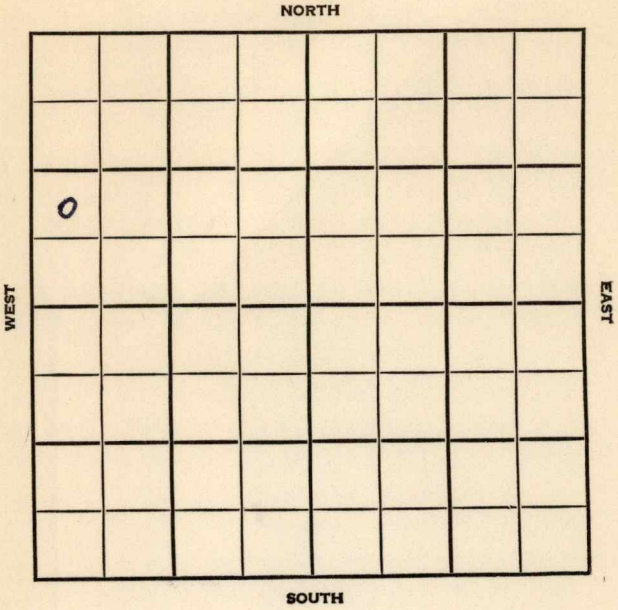

KANSAS

CONTRACTOR

Phillips Pet.

Phillips

Chase-Silica Pool NORTH

Ft. from N. Line

990


Ft. from S. Line

Ft. from E. Line

330

Ft. from W. Line

C NW SWNW

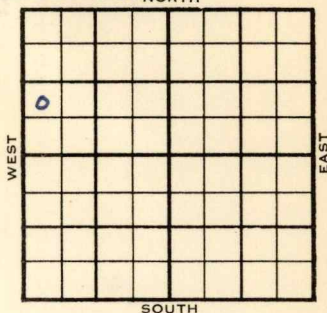

1954

ELEVATION

1749'

REPORT

9/8

Location

10/13

Spud 9-16-54 - Oil Well

TD 3293'

10-3/4" @ 170'

Heeb 2785', Tor 2808', Doug 2819',

Br. Lime 2914', Lans 2936', Cong.

3272', Arb. 3286'

TD 3290'

Schl tops: B KC 3239', Cong 3259'.

Arb. 3281!

7" @ 3283'

TD 32851

CO to 3286!

B/4 bo 8 bw 2 hrs.

B/3.01 bo 5 bw 3 hrs.

DD 3290'

B/2 $\frac{1}{2}$ to 2 $\frac{1}{2}$ hrs., 500^A

S/6 bo 9 bw 5 hrs.

DD 32931

S/97 bo-4 bw 7 hrs.

Comp. 60 bopd 40 bw

COMPLETED

County **Rice** State **Kansas**

Sec. 18 (Blk. Twp.) 19 (Sur. Rge.) 9W Map No.

Operator Phillips Pet.

Well No. 4 Farm Kate

Elev.	Location	C	NW	SW	NW
-------	----------	---	----	----	----

990 Ft. From S Line NW

330	Ft. From	W	Line	Quarter
-----	----------	---	------	---------

1st. Report SEP 8 1954

Completion

Remarks

Phillips - Contr.

Spudding Date _____

Drlg. Data Chase-Silica Pool

Location

FABEN GILSTRAP

County Rice State Kansas
 Sec. 18 (Blk.
Tw.) 19 (Sur.
Rge.) 9W Map No.

Operator Phillips Pet.

Well No. 4 Farm Kate

Elev. 1749 Location C NW SW NW

990 Ft. From S Line NW

330 Ft. From W Line Quarter

1st. Report

OCT 13 1954

Completion

Remarks Chase-Silica Pool

Phillips - Contr.

Spudding Date 9-16-54

Drlg. Data Oilwell TD 3293

10 3/4" @ 170 Heeb. 2785 Tor. 2808

Doug. 2819 Br. lime 2914 Lans. 2936

Cong. 3272 Arb. 3286 TD 3290

SCHLUMBERGER TOPS B KC 3239 Cong. 3259

Arb. 3281 7" @ 3283 TD 3285 CO to

3286 B/ 4 bo 8 bw 2 hr. B/ 3.01 bo

5 bw 3 hr. DD 3290 B/ 2 1/2 bo 2 1/2 hr.

500 A S/ 6 bo 9 bw 5 hr. DD 3293

S/ 97 bo 4 bw 7 hr.

Comp. 60 bopd 40 bw

FABEN GILSTRAP