


Section 18 Township 19 Range 9-W

Well No. #1 Link

Company C. H. Weaver

NORTH Chase Pool

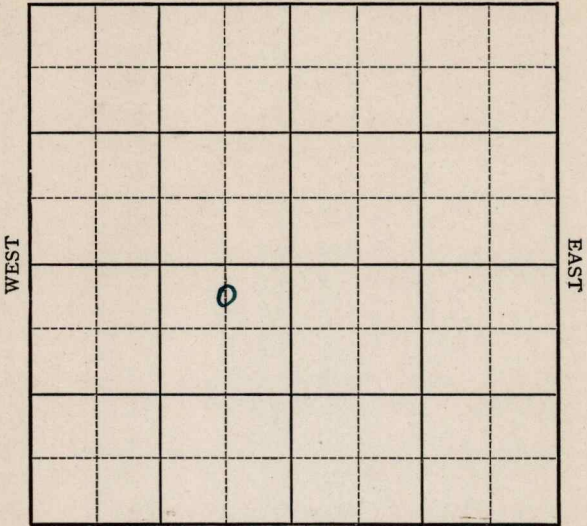

SOUTH

Sec. 18 Twp. 19 R. 9-W

Well No. #1 Link Farm

C. H. Weaver Company

(Chase)


330 Ft. from N. Line

Ft. from S. Line

~~330~~ ⁶⁶⁰ Ft. from E. Line

Ft. from W. Line

Elev. 1740

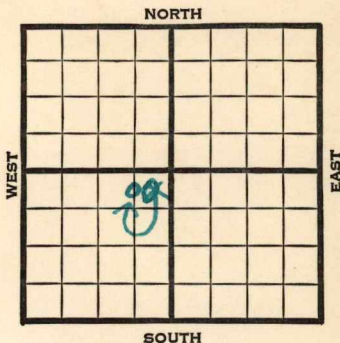

1941

REPORT

5/21 8" - 134' **Anhy. 390'**

Drlg. 560'

5/28 **Lans. 2922'** Drlg. 3180'

6/5 **Arb. 3262'** 5" - 3263'

T.D. 3273' 1600' oil 3 hours.

6/11 **Arb. 3262'**

5" - 3263'

T.D. 3271'

3000 acid.

Depthograph potential 1395 bbls.

42.6 Gravity

COMPLETED

Map No. 49 Sec. 18 Twp. 19 R. 9W

Well No. 1 Link

C. H. Weaver Company

FIRST REPORT Contractor

NE SW

330 Ft. from N. Line

_____ Ft. from S. Line

330 Ft. from E. Line

_____ Ft. from W. Line

SECTION PLAT

CHASE POOL

Location _____

Rig up _____

Drilling and Remarks:

8" - 134

Anhy. 390

Drlg. 560

RECORD

Cased _____ in., _____ ft.

Sand _____

Gas _____

Oil _____

Total Depth _____

PRODUCTION

1st 24 hrs. Nat. _____

1st 24 hrs. after shot _____

Gas _____ Cu. Ft.

Dry Hole _____

Abandoned _____

Date

MAY 21 1941 19

S. J. LEWIS Scout

Map No. 49 Sec. 18 Twp. 19 R. 9W

Well No. 1 Link

C. H. Weaver Company

CORRECTION Contractor

C N L NE SW

330 Ft. from N. Line

_____ Ft. from S. Line

660 Ft. from E. Line

_____ Ft. from W. Line

CHASE POOL

SECTION PLAT

	o		

Location _____

Rig up _____

Drilling and Remarks:

Reported
NE SW

RECORD

Cased _____ in., _____ ft.

Sand _____

Gas _____

Oil _____

Total Depth _____

PRODUCTION

1st 24 hrs. Nat. _____

1st 24 hrs. after shot _____

Gas _____ Cu. Ft.

Dry Hole _____

Abandoned _____

Date _____

Map No. 49 Sec. 18 Twp. 19 R. 9W

Well No. 1 Link

C. H. Weaver Company

COMPLETED Contractor

SECTION PLAT

C N L NE SW

	o		

330 Ft. from N. Line

_____ Ft. from S. Line

660 Ft. from E. Line

_____ Ft. from W. Line

CHASE POOL

Location _____

Rig up _____

Drilling and Remarks:

Cor & 3262
5" @ 3263
3000 acid
Depth 3295
42 @ Gr

RECORD

Cased _____ in., _____ ft.

Sand _____

Gas _____

Oil _____

Total Depth 3291

PRODUCTION

1st 24 hrs. Nat. _____

1st 24 hrs. after shot _____

Gas _____ Cu. Ft.

Dry Hole _____

Abandoned _____

Date

JUN 11 1941 19

S. J. LEWIS Scout