

G.W.W.O.

McPherson KANSAS

DX 78-1

Section 13 Township 21 Range 2W

Well No. 10 Rupp

Company Shelly-Miller *E.K. Carey*

NORTH

WEST

EAST

0							

SOUTH

McPherson KANSAS

SEC.	TWP.	R.
13	21	2W

WELL NO. 1 Rupp FARM

COMPANY Shelly Miller

CONTRACTOR Shelly Miller


Wildcat

\_\_\_\_\_ Ft. from N. Line

330 \_\_\_\_\_ Ft. from S. Line

\_\_\_\_\_ Ft. from E. Line

330 \_\_\_\_\_ Ft. from W. Line

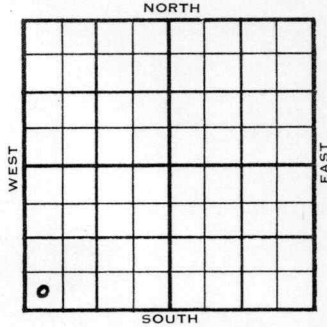

SW SW SW

	ELEVATION	REPORT
1954	1495'	

6/30	M I R
7/7	8" @ 129 w/110 Drlg. 2580'
7/14	Spud 6-30-54 - D&A TD 3029' 8" @ 129' Lans 2319', Cong 2930', Miss 2959' TD 3029' DST 2960-80, opn 1 hr., rec. 15' gcm, 725# D&A

**ABANDONED**





O.W.W.O.

FORM 513 SUNRAY

County McPherson Elev. 1497 Co.       
 Sec. 13 Twp. 21 Rge. 2W  
 Company E. K. Carey  
 FarmName Rupp No. 1

TOPS	DEPTH	LOG	DATUM
Anh.			
Tp.			
H.			
Tr.			
Dg.			
Bl.			
L.			
K.C.			
B.K.C.			
Ce.			
C.			
M.			
M.			
K.			
Mz.			
Me.			
V.			
S.			
S.			
A.			
R.			
PE.			
G.			
T.D.			

Loc. in Sec.     OWWOSW SW SWGeol.     Contr.     Pool     

FIRST REPORT

DEC 2 '56

Date Comm.     OTD 3029 MIR

Co.

Loc.

No.

Sec.

T.

R.

Gaunty McPherson Elev. 1497  
 Sec. 13 Twp. 21 Rgs. 2W  
 Company E. K. Carey  
 FarmName Rupp No. 1

TOPS	DEPTH	LOG	DATUM	Loc. in Sec.
Anh.				<u>OWWO</u>
Tr.				<u>SW SW SW</u>
Dg.				
Bl.				
L.				Geol. _____
K.C.				Contr. _____
B.K.C.				
Ce.				
C.				
M.	<u>2959</u>			
M.	<u>Base 3254</u>			Pool
K.				
Mz.	<u>3332</u>			
Mo.	<u>Hunt 3337</u>			
V.	<u>3434</u>			
S.				
S.				
A.				
R.				
Pe.				
G.				
T.D.	<u>3450</u>			

ABANDONED

DEC 26 '56

Date Comm. OTD 3029 MIR DEC 19 '58 WOK DEC 26 '56

*D.P.A.*

Co.  
Use.  
No.  
Sec.  
T.  
R.