


Section 18 Township 19 Range 9 W

Well No. # 3 Link (A)

Company Aylward Drilling

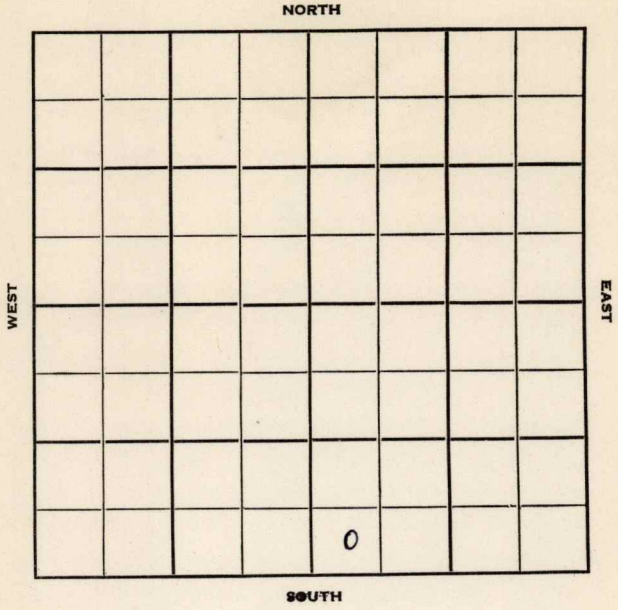

Sec. 18 Rice Twp. 19 R. 9 W ✓

Well No. # 3 Link (A) Farm

Aylward Drilling Company

Contractor


 Ft. from N. Line

330 Ft. from S. Line

 Ft. from E. Line

330 Ft. from W. Line

SW SW SE

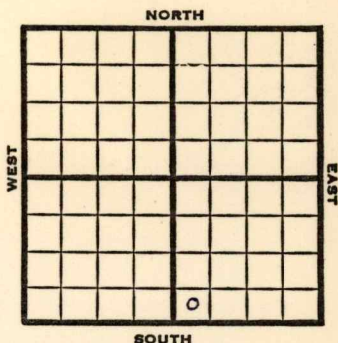

1951 Elev. 1739' REPORT

7/3 Spud 6-26-51
8" @ 195 Anhy 380'
Drlg. 2625'

9/12 Spud 6-26-51
Oil Well TD 3296
8" @ 195 Anhy 380
Lans. 2924 BKC 3214
Cong. 3235 Simp 3269
DST 3269-80 opn 1 hr Rec. 200' ocm
TD 3296 5" @ 3269 FU 250' oil
overnite DD 3298 FU 900' oil
45/3270-84 6 bopd PB 3208
35/3144-56 1000 A S/3 bwph SSO
18/3110-16 S/2 bo 2 bwph
Comp. 50 bopd 50% wtr.

COMPLETED

J. E. TYRA

