

KANSAS

Rice

Section 18 Township 19 Range 9W

Well No. 1 Link "B"


Company Tatlock & Aylward

Chase

NORTH

WEST

EAST

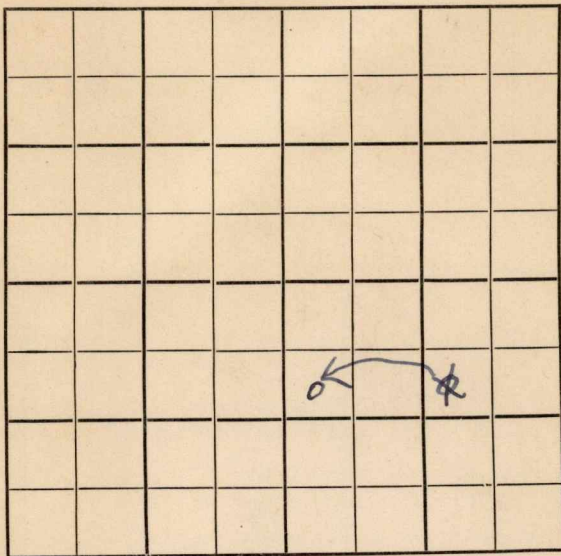

SOUTH

Rice

KANSAS

Sec. 18 Twp. 19 R. 9W ✓

Well No. #1 Link "B" Farm

Tatlock & Aylward Company

Chase Pool (Aylward, Cont.)

NORTH


990' Ft. from N. Line

Ft. from S. Line

990' Ft. from E. Line

336 Ft. from W. Line

SW ^{NW} NE SE

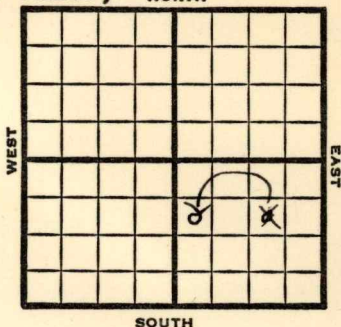

1949

Elev. 1737' REPORT

6/15 10" @ 235'
6/21 Lansing 2900'
Drlg 2910'
6/28 TD 3013'
7" @ 3009'
7/6 Simpson 3215?
TD 3270'
7/12 "
7/20 Complete
Simp. 3258'
7" @ 3009'
5" @ 3258'
Pump 25 oil Pot
44 Grav.
TD 3270'

COMPLETED

Rice County Kansas State

Map No. _____ Sec. 18 Twp. 19 R. 9W

Well No. 1 Link "B"

Tatlock & Aylward Company

Aylward Contractor

FIRST REPORT SECTION PLAT

SW NE SE

990 Ft. from N. Line

Ft. from S. Line

990 Ft. from E. Line

Ft. from W. Line


Chase Pool

Remarks:

10¹¹ @ 235

Date JUN 15 1949 Scout S. J. LEWIS

Map No. _____ Sec. 18 Twp. 19 R. 9W

Well No. 1 Linke "B"

Tatlock & Aylward Company

CORRECTION

Contractor

SW NW SE


SECTION PLAT

990 Ft. from N. Line

_____ Ft. from S. Line

_____ Ft. from E. Line

330 Ft. from W. Line

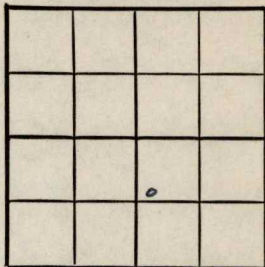

Rice County

Location _____

Rig up _____

Drilling and Remarks:

Reported

SW NE SE

RECORD

Cased _____ in., _____ ft.

Sand _____

Gas _____

Oil _____

Total Depth _____

PRODUCTION

1st 24 hrs. Nat. _____

1st 24 hrs. after shot _____

Gas _____ Cu. Ft.

Dry Hole _____

Abandoned _____

Date

JUN 22 1949

19

S. J. LEWIS

Scout

Kansas

Chase Pool

Map No. K 49 Sec. 18 Twp. 19 R. 9WWell No. 1 Link "B"Tatlock & Aylward

Company

COMPLETE

Contractor

SW NW SE

E 1,1737
SECTION PLAT990

Ft. from N. Line

Ft. from S. Line

Ft. from E. Line

330

Ft. from W. Line

Rice County

Location

Rig up

Drilling and Remarks:

*Comp 3258**7" C 3009**5" C 3258**Pump 25 oil Rod**44 2/3***RECORD**

Cased _____ in., _____ ft.

Sand _____

Gas _____

Oil _____

Total Depth 3270**PRODUCTION**

1st 24 hrs. Nat. _____

1st 24 hrs. after shot _____

Gas _____ Cu. Ft.

Dry Hole _____

Abandoned _____

Date

JUL 20 194919S. J. LEWIS

Scout