


Rice


Form 51-5M 5-37 Petrol

Section 18 Township 19 Range 9-W
 Well No. 2 - Wilcox
 Company Ohio

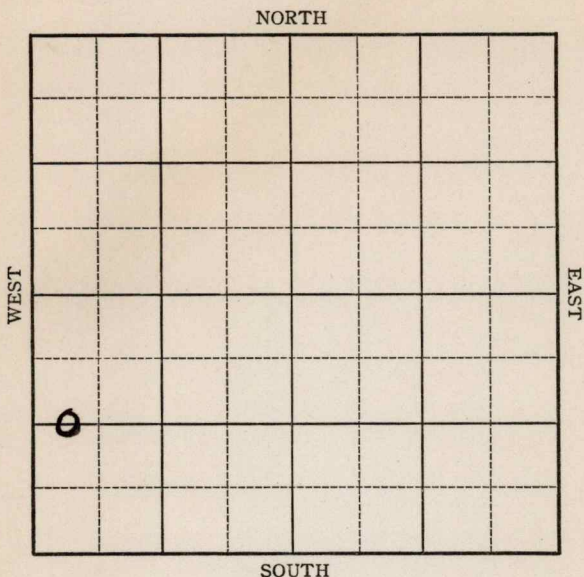

Sec. 18 Twp. 19 R. 9-WWell No. #2 Wilcox FarmOhio Company Ft. from N. Line1320 Ft. from S. Line Ft. from E. Line330 Ft. from W. Line

Elev. 1743

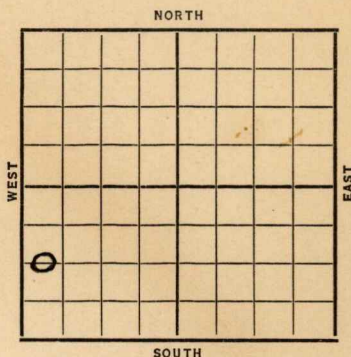

Date	REPORT
1937	
8/4	Location
8/13	R. U.
8/20	20" @ 135'. T.D. 425'. WOC.
8/28	15" @ 1085'. Drlg. 1250'.
9/3	13" @ 1570'. Drlg. 2055'.
9/10	10" @ 2268'. Drlg. 2725'.
9/17	8" @ 2948'. S.O. 3050-55'.
	6" @ 3244'. Cong. 3258'.
	Drlg. 3270'. No shows. rep.
9/24	Sil. ~~3292'~~ ³²⁸⁹ 6" @ 3291'.
	S.O. 3297 T.D. P.B.P.
10/2	T.D. 3303' S.W.
	P.B. 3300'. 1½ bailers oil 12
	hrs. Shot 15 qts. C.O.
10/8	Fsg.
10/15	Sil. 3289' (Corrected)
10/22	" " " "
10/29	" " " "
11/5	P.B. for S.W.D.
11/12	P.B. 1572'. 8" @ 1515'. WOC.

OVER

1937

11/19 P.B. 1572'. 8" @ 1515'. WOC.

11/23 6" @ 3291'.

Sil. 3289' (Corrected)

T.D. 3303'.

1½ bailers oil in 12 hrs.

Shot 15 qts.

P.B. 1572 for S.W.D.

8" @ 1515'.

Input-5 bbls. water per hour.

ABANDONED

Rice **KANSAS**Map No. 49 Sec. 18 Twp. 19 R. 9 WWell No. 2 - WilsonOhio

Company

Contractor

FIRST REPORT

SECTION PLAT

0			

 Ft. from N. Line1320 Ft. from S. Line Ft. from E. Line330 Ft. from W. LineLocation ✓Rig up

Drilling and Remarks:

RECORD

Cased in., ft.Sand Gas Oil Total Depth

PRODUCTION

1st 24 hrs. Nat. 1st 24 hrs. after shot Gas Cu. Ft.Dry Hole Abandoned

Date

AUG 4 - 1937 19H. D. Hatfield Scout

Rice

KANSAS

Map No. 47 Sec. 18 Twp. 19 R. 9WWell No. 2 WilcoxOhio

Company

Contractor

COMPLETED
C W L SW**SECTION PLAT**

 Ft. from N. Line1320 Ft. from S. Line Ft. from E. Line330 Ft. from W. LineLocation Rig up

Drilling and Remarks:

1 1/2 Bailers oil IN 12 hrsshot 15 gtoP.B. 1572 For S.W.D.8" - 1515Input - 5 bbls waterP.H.**RECORD**Cased 6 in. 3291 ft.Sand 511 3289Gas (Corrected)Oil Total Depth 3303**PRODUCTION**1st 24 hrs. Nat. 1st 24 hrs. after shot Gas Cu. Ft.Dry Hole Abandoned

Date

NOV 23 1937

19

H. D. Hatfield

Scout