


Section 18 Township 19 Range 9W
Well No. 2 Wilcox
Company Stearns Petr.

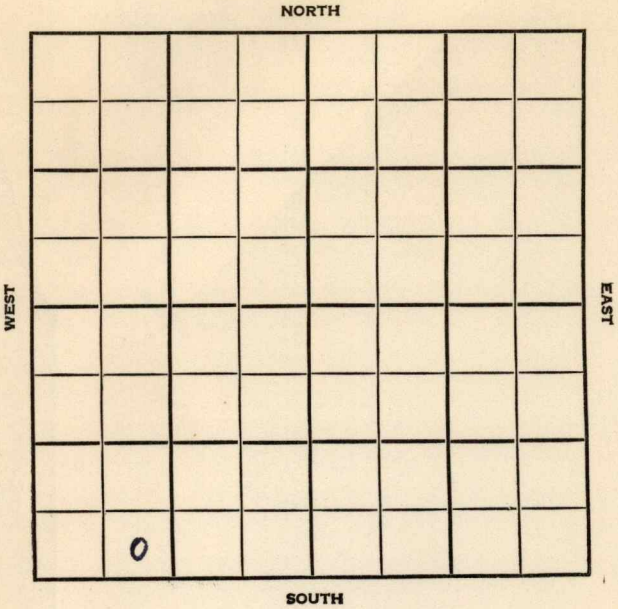

Rice

KANSAS

SEC.	TWP.	R.
18	19	9W

WELL NO.

#2 Wilcox

FARM

COMPANY

Stearns Pet.

CONTRACTOR

Stearns

Chase-Silica Pool

Ft. from N. Line

330


Ft. from S. Line

Ft. from E. Line

990

Ft. from W. Line

SE SW SW

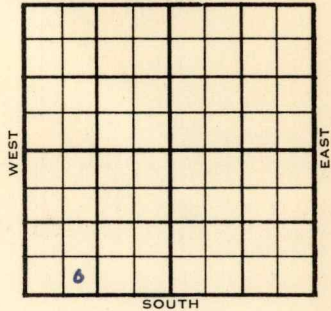

	ELEVATION	REPORT
1954	1742'	

9/8

Spud 9-2-54

8" @ 217'

Drlg. 2060'

9/15

Spud 9-2-54 - D&A

TD 3298'

8" @ 217'

Heeb 2779', Tor 2804', Doug 2819'

Br. lime 2907', Lans 2931'

DST 3260-80', opn 1 hr., rec.

10' SOCM, 290#

Arb. 3288'

DST 3289-93', opn 1 hr., rec. 8'

mud, 0#

DST 3291-98', opn 1 hr., rec.

15' mud, 330#

TD 3298'

D&A

ABANDONED

