


KANSAS

Rice

Section 19 Township 19 Range 9WWell No. 1 EmerickCompany J.C. DozierChase
NORTH

WEST

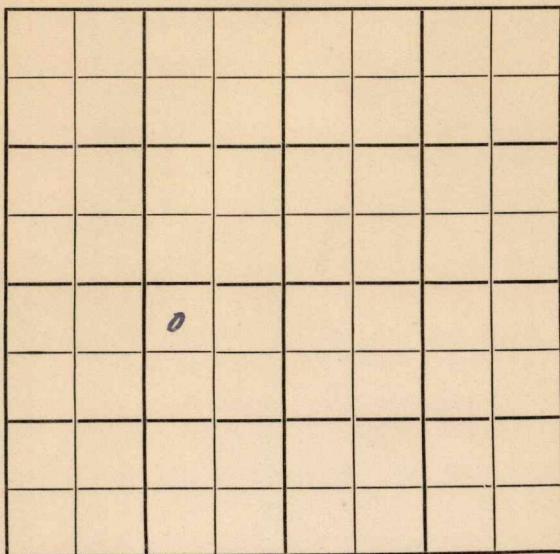

EAST

SOUTH

Rice

KANSAS

Sec. 19 Twp. 19 R. 9W ✓

Well No. #1 Emmerick Farm

J. C. Dozier Company

Chase Pool

330' Ft. from N. Line


 Ft. from S. Line

990'

 Ft. from E. Line

 Ft. from W. Line

NW NE SW

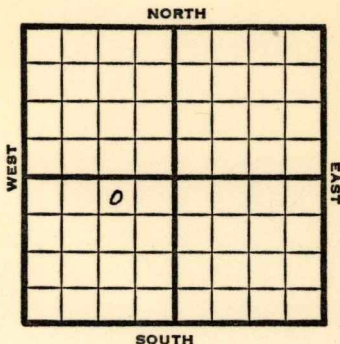

1949

Elev 1735'

REPORT

6/15

8" @ 180'
Drlg. 2540'

6/21

Lansing 2927'
Arb. 3268-70'

TD 3270'
5"@ 3268'

6/29

TD 3275'
Arb 3268'
5"@ 3268'
500 acid
Pump 75 oil Pot
42° Gr.
Comp

COMPLETED

Rice County Kansas State

Map No. _____ Sec. 19 Twp. 19 R. 9W

Well No. 1 Emerick

J. C. Dozier Company

Lewis Contractor

NW NE SW

FIRST REPORT
SECTION PLAT

330 Ft. from N. Line

_____ Ft. from S. Line

990 Ft. from E. Line


_____ Ft. from W. Line

Chase Pool

Remarks:

8" @ 180

drlg. 2540

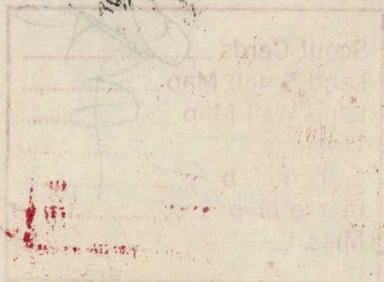

Date
JUN 15 1949

Scout
S. J. LEWIS

Map No. K49 Sec. 19 Twp. 19 R. 9W

Well No. 1 Emerick

J. C. Dozier Company

COMPLETE

Contractor

NW NE SW

E 1/2 35
SECTION PLAT

330 Ft. from N. Line

_____ Ft. from S. Line

990 Ft. from E. Line

_____ Ft. from W. Line

	6		

Rice County

Location _____

Rig up _____

Drilling and Remarks:

Cu x 3268

5" @ 3268

5000 and 10

Only 25 oil BT

42 3/4

RECORD

Cased _____ in., _____ ft.

Sand _____

Gas _____

Oil _____

Total Depth 3225

PRODUCTION

1st 24 hrs. Nat. _____

1st 24 hrs. after shot _____

Gas _____ Cu. Ft.

Dry Hole _____

Abandoned _____

Date

JUN 29 1949

19

S. J. LEWIS

Scout