


SECTION 32 TOWNSHIP 21S RANGE 2W

WELL NO. #1 Goering

COMPANY E.K. Carey

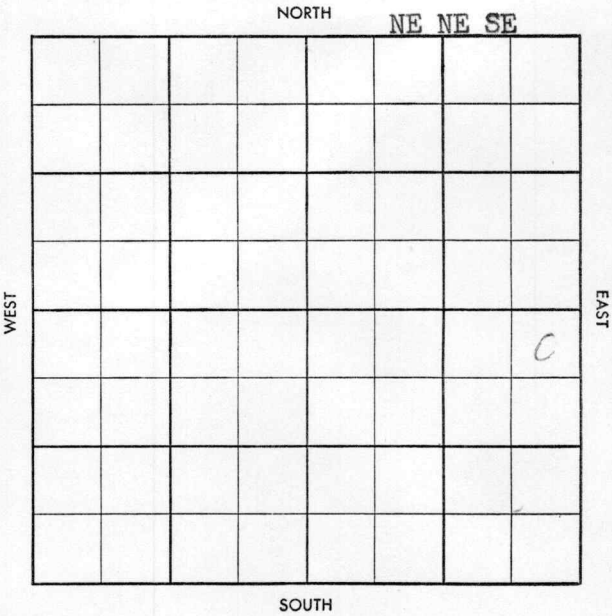

No. X Pool X  
 Co. X Facet X

19A-M

# WILDCAT

S-513-B

County McPherson Elev. \_\_\_\_\_  
 Sec. 32 Twp. 21 Rge. 2W  
 Company E. K. Carey  
 Farm Name Goering No. 1

| TOPS   | DEPTH | LOG | DATUM |
|--------|-------|-----|-------|
| Anh.   |       |     |       |
| Tp.    |       |     |       |
| H.     |       |     |       |
| Tr.    |       |     |       |
| Dg.    |       |     |       |
| B.L.   |       |     |       |
| L.     |       |     |       |
| K.C.   |       |     |       |
| B.K.C. |       |     |       |
| Ce.    |       |     |       |
| C.     |       |     |       |
| M.     |       |     |       |
| M.     |       |     |       |
| K.     |       |     |       |
| Mz.    |       |     |       |
| Mq.    |       |     |       |
| V.     |       |     |       |
| S.     |       |     |       |
| S.     |       |     |       |
| A.     |       |     |       |
| R.     |       |     |       |
| Pf.    |       |     |       |
| G.     |       |     |       |
| T.D.   |       |     |       |

Loc. in Sec. \_\_\_\_\_

NE NE SE

Geol. \_\_\_\_\_

Contr. \_\_\_\_\_

Capitt

Pool \_\_\_\_\_

Wildcat

**FIRST REPORT**

JUL 30 '58

Date Comm. 7-24-58 Lario & B & G -DHM  
8 5/8" @ 219/215 drlg. 2250

Co.  
Lse.  
No.  
Sec.  
T.  
R.

Typ. No Pool   
 Co.  Facet No

S-513-B

County McPherson Elev. 1478 DF 1481 RB  
 Sec. 32 Twp. 21 Rge. 2W  
 Company E. K. Carey  
 Farm Name Goering No. 1

| TOPS                     | DEPTH       | LOG         | DATUM |
|--------------------------|-------------|-------------|-------|
| Anh.                     |             |             |       |
| Tp.                      |             |             |       |
| H.                       |             |             |       |
| Tr.                      |             |             |       |
| Dg.                      |             |             |       |
| B.L.                     |             |             |       |
| L.                       | <u>2406</u> |             |       |
| K.C.                     |             |             |       |
| B.K.C.                   |             |             |       |
| Ce.                      |             |             |       |
| C.                       |             |             |       |
| M.                       | <u>3112</u> |             |       |
| M.                       |             |             |       |
| K.                       |             |             |       |
| Mz.                      | <u>3477</u> |             |       |
| <del>W</del> <u>Hunt</u> | <u>3499</u> | <u>3502</u> |       |
| <del>W</del> <u>M.R.</u> | <u>3534</u> | <u>3535</u> |       |
| <del>W</del> <u>V</u>    | <u>3615</u> | <u>3615</u> |       |
| S.                       | <u>3645</u> | <u>3645</u> |       |
| A.                       |             |             |       |
| R.                       |             |             |       |
| Pf.                      |             |             |       |
| G.                       |             |             |       |
| T.D.                     | <u>3669</u> |             |       |

Loc. in Sec. NE NE SE

Geol. \_\_\_\_\_  
 Contr. Capitt

Pool Wildcat

**ABANDONED**  
 AUG 13 '58

Date Comm. 7-21-58 Lario & B & G - DIEM  
8 5/8" @ 219/215 drlg. 2250

AUG 6 '58 Ø 3544 AUG 13 '58 log

D-6A