


Rice **KANSAS**

Section 19 Township 19 Range 9W
Well No. #2 Emerich (Emerick)
Company J. C. Dozier

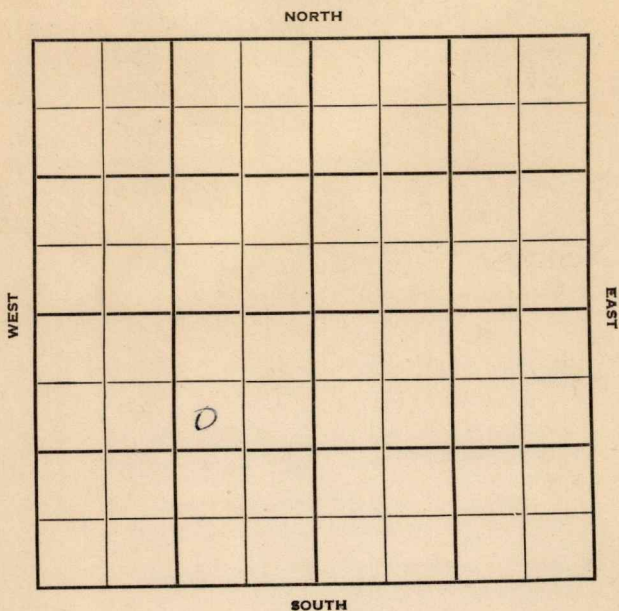

Sec. 19 Twp. 19 R. 9W ✓

Well No. #2 Emerich Farm

J. C. Dozier Company

Lewis Drlg. Contractor

Chase Pool


990' Ft. from N. Line

 Ft. from S. Line

990' Ft. from E. Line

 Ft. from W. Line

SW NE SW

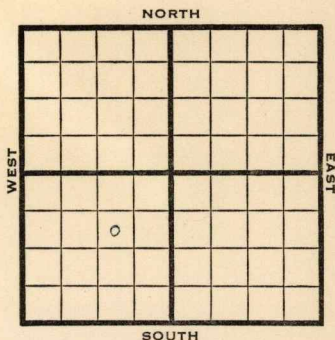

1950

Elev 1734'

REPORT

3/22

RUR

4/12

TD 3274'

8 5/8" @ 158'

Heeb 2771'

Lans 2925'

Arb. 3254'

5"@ 3256'

30 BOPD

Comp

COMPLETED

Kansas

Chase Pool


Map No. _____ Sec. 19 Twp. 19 R. 9WWell No. 2 Emerich_____
J. C. Dozier Company_____
Lewis Drlg. Contractor

SW NE SW

SECTION PLAT

990 Ft. from N. Line_____
Ft. from S. Line990 Ft. from E. Line_____
Ft. from W. Line

Rice County

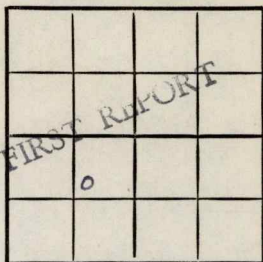

Location _____

Rig up _____

Drilling and Remarks:

R U R

RECORD

Cased _____ in., _____ ft.

Sand _____

Gas _____

Oil _____

Total Depth _____

PRODUCTION

1st 24 hrs. Nat. _____

1st 24 hrs. after shot _____

Gas _____ Cu. Ft.

Dry Hole _____

Abandoned _____

Date

MAR 22 1900

19


J. E. TYRA

Scout

Kansas

Map No. _____ Sec. 19 Twp. 19 R. 9WWell No. 2 Emerich_____
J. C. Dozier Company_____
Contractor

SW NE SW

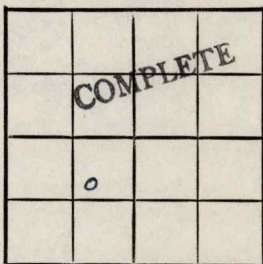E/ 1734
SECTION PLAT990 Ft. from N. Line_____
Ft. from S. Line990 Ft. from E. Line_____
Ft. from W. Line

Rice County

Location _____

Rig up _____

Drilling and Remarks:

8 5/8" @ 158Kerb 2771Lans 2925Ant 32545" @ 325630 BOPD

RECORD

Cased _____ in., _____ ft.

Sand _____

Gas _____

Oil _____

Total Depth 3274

PRODUCTION

1st 24 hrs. Nat. _____

1st 24 hrs. after shot _____

Gas _____ Cu. Ft.

Dry Hole _____

Abandoned _____

Date

APR 12 1950

19

J. E. TYRA

Scout