


Map No. KANSAS Sec. 3 Twp. 21 R. 3^w

Well No. 1 - Fresh Oil Farm _____
Gypsy Oil Company _____

NORTH

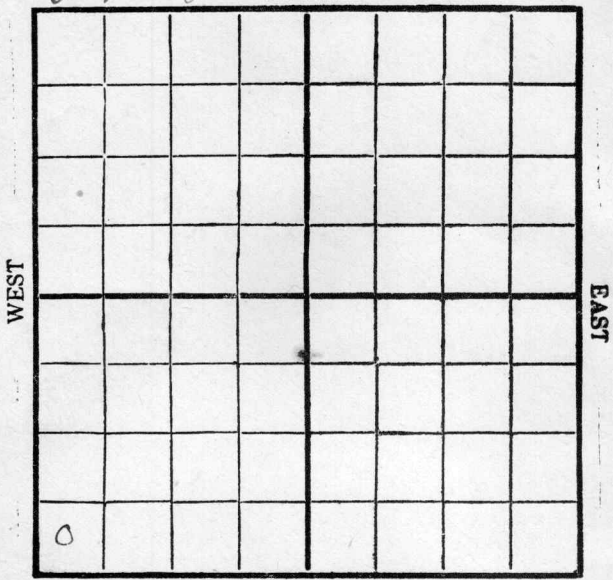

SOUTH

Location _____

Drilling Remarks _____

Rig Up _____

Drilling Remarks _____

RECORD

Cased _____ in. _____ ft.
Sand _____
Gas _____
Oil _____
Total Depth _____

PRODUCTION

1st 24 hrs. Nat. _____
1st 24 hrs. after shot _____
Gas _____ cu. ft. _____
Dry Hole _____
Abandoned _____


M. C. Pherson

Map No. KANSAS Sec. 3 Twp. 21 R. 3^w

Well No. 1- Grebbil Farm

Gypsy Oil Company

NORTH

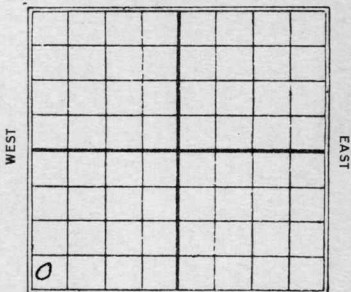

SOUTH

..... Ft. from N. Line

330 Ft. from S. Line

..... Ft. from E. Line

330 Ft. from W. Line

1930

Date

REPORT

<u>1/8</u>	<u>Bldg Rig (rotary)</u>
<u>1/15</u>	<u>fy</u>
<u>1/22</u>	<u>Spud</u>
<u>1/29</u>	<u>Drill 7600'</u>
<u>2/5</u>	<u>Sp" 2515'</u>
<u>2/12</u>	<u>Shot 3002-05' Rust</u>
<u>2/19</u>	<u>2nd gas - 3070-75'</u>
	<u>Base line 3125'</u>
	<u>Drill 3150'</u>
<u>2/26</u>	<u>Sandy lime 3357-59'</u>
	<u>Filled up 2000' oil</u>
	<u>in 2 hrs.</u>
<u>3/5</u>	<u>6" 3339 Drill 3371'</u>
<u>3/12</u>	<u>Milcox 3424-28'</u>
	<u>T.D. 3428'</u>
	<u>swab 852 bbl oil</u>
	<u>50mp</u>

Map No. KANSAS Sec. 8 Twp. 21 R. 3W

Well No. 43 1 Kreckiel

Gypsy Oil Company
Gypsy Oil Contractor

SECTION PLAT

0			

_____ Ft. from N. Line
330 Ft. from S. Line
_____ Ft. from E. Line
330 Ft. from W. Line

FIRST REPORTS

Location _____

Rig up _____

Drilling and Remarks:

Building rig
Rotary

RECORD

Cased _____ in., _____ ft.
Sand _____
Gas _____
Oil _____
Total Depth _____

PRODUCTION

1st 24 hrs. Nat. _____
1st 24 hrs. after shot _____
Gas _____ Cu. Ft.
Dry Hole _____
Abandoned _____

Date

JAN 8 1930

S. J. LEWIS Scout

M. P. Merriam

Map No. KANSAS Sec. 8 Twp. 21 R. 2W

Well No. 1 Herk Hiel

Gypsum Oil Company

Contractor

SECTION PLAT

..... Ft. from N. Line

330 Ft. from S. Line

..... Ft. from E. Line

330 Ft. from W. Line

o			

COMPLETED

Location.....

Rig up.....

Drilling and Remarks:

Wilcox 3424-28

swaby 8528 1/2

RECORD

Cased..... in., ft.

Sand.....

Gas.....

Oil.....

Total Depth 3428

PRODUCTION

1st 24 hrs. Nat.....

1st 24 hrs. after shot.....

Gas..... Cu. Ft.

Dry Hole.....

Abandoned.....

Date

MAR 12 1930

S. J. LEWIS

Scout