

*M<sup>c</sup>Pherson*


Form 51-5M-2-29-34703

Map No. **KANSAS** Sec. \_\_\_\_\_ Twp. *21* R. *3w*

Well No. *2 - Moorehouse* Farm \_\_\_\_\_

*Independent* Company \_\_\_\_\_

NORTH

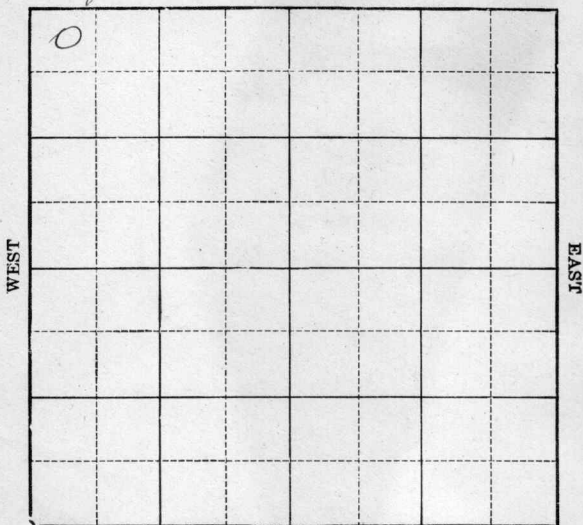

SOUTH

*OWDD*

Location \_\_\_\_\_

Drilling Remarks \_\_\_\_\_  
\_\_\_\_\_  
\_\_\_\_\_  
Rig Up \_\_\_\_\_

Drilling Remarks \_\_\_\_\_  
\_\_\_\_\_  
\_\_\_\_\_  
**RECORD**

Cased \_\_\_\_\_ in. \_\_\_\_\_ ft.

Sand \_\_\_\_\_

Gas \_\_\_\_\_

Oil \_\_\_\_\_

Total Depth \_\_\_\_\_

**PRODUCTION**

1st 24 hrs. Nat. \_\_\_\_\_

1st 24 hrs. after shot \_\_\_\_\_

Gas \_\_\_\_\_ cu. ft. \_\_\_\_\_


Dry Hole \_\_\_\_\_

Abandoned \_\_\_\_\_

Map No. KANSAS Sec. 3 Twp. 21 R. 3<sup>w</sup>

Well No. 2 - Moorehouse Farm  
Independent Oil Company

330 Ft. from N. Line  
 \_\_\_\_\_ Ft. from S. Line  
 \_\_\_\_\_ Ft. from E. Line  
330 Ft. from W. Line  
1930

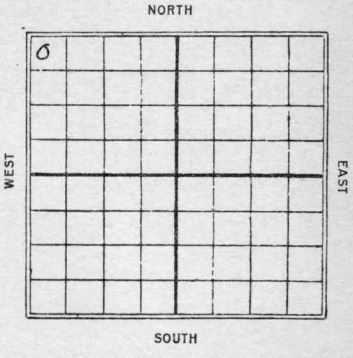

Date	REPORT
5/14	ROB (Rotary)
5/21	Bldg. rig
5/28	hdlg. 4310'
6/4	" 2660'
6/11	Chat 3027' Cen. 8"
6/18	6" gas-spray oil-hdlg. 3115'
6/25	hdlg. 32070'
7/2	Viola 3372'
	6" 3375' Base
	Viola 3422'
	hdlg. 3428'
7/9	Wells 3424-48 TD 3448
	swab 650 gal Corp.
1931	OWDD
5/27	Old TD. 3448
	Top Silic lime 3495
	T.D. 3497
	Swab 15 bbl water hour
	517. 3497 for orders

6/3. T.D. 3497  
plugging back to 3465  
6/10. Top Silice lime 3495  
T.D. 3497 water  
P.B. 3465  
shot 5 qt 3424-44  
Pump 25 bbl oil  
and 50 " water  
Comp.

*M. Nelson*  
 Map No. **KANSAS** Sec. *3* Twp. *21* R. *3W*  
 Well No. *2. Moore house*  
*Independent Oil & Gas* Company  
 Contractor

**SECTION PLAT**

*800* Ft. from N. Line  
 ..... Ft. from S. Line  
 ..... Ft. from E. Line  
*800* Ft. from W. Line

0			

**FIRST REPORTS**

Location.....  
 Rig up.....  
 Drilling and Remarks:  
*Rotary*  
*R&R*

**RECORD**

Cased.....in., .....ft.  
 Sand.....  
 Gas.....  
 Oil.....  
 Total Depth.....

**PRODUCTION**

1st 24 hrs. Nat.....  
 1st 24 hrs. after shot.....  
 Gas..... Cu. Ft.  
 Dry Hole.....  
 Abandoned.....

Date

*MAY 14 1930*

192.....

*S. J. LEWIS* Scout

Map No. **KANSAS** Sec. 02 Twp. 21 R. 04W

Well No. 2. Motor house

Independent Oil & Gas Company

Contractor

**SECTION PLAT**

330 Ft. from N. Line

..... Ft. from S. Line

..... Ft. from E. Line

330 Ft. from W. Line

0			

**COMPLETED**

**RECORD**

Location.....

Cased..... in., ..... ft.

Rig up.....

Sand.....

Drilling and Remarks:

Gas.....

Oil.....

Wilcox 3424-48

Total Depth 3448

**PRODUCTION**

swath 6508 1/2

1st 24 hrs. Nat.....

1st 24 hrs. after shot.....

Gas..... Cu. Ft.

Dry Hole.....

Abandoned.....

Date

JUL 9 1930

S. J. LEWIS Scout

*McPherson*

43 KANSAS Map No. Sec. 3 Twp. 21 R. 3 <sup>W</sup>

Well No. *2* *McPherson*

*Independent Oil & Gas* Company

Contractor

FIRST REPORTS

SECTION PLAT

330 Ft. from N. Line

Ft. from S. Line

Ft. from E. Line

330 Ft. from W. Line

0			

"*Old Well Deeper*"

Location

*715 Was 3448*  
Rig up

Drilling and Remarks:

*Top Sili 3495*  
*2D 3497*  
*Swabbed 15 lbs water*  
*Per hour.*  
*A/D per orders.*

RECORD

Cased in., ft.  
Sand  
Gas  
Oil  
Total Depth

PRODUCTION

1st 24 hrs. Nat.  
1st 24 hrs. after shot  
Gas Cu. Ft.  
Dry Hole  
Abandoned

Date

MAY 27 1931

CHAS. L. SHERWOOD

192 Scout

*McPherson*

Map No. 43 **KANSAS** Sec. 3 Twp. 21 R. 3<sup>W</sup>

Well No. 2 *Meachouse*

*Independent Oil "Phillips"* Company

Contractor

**COMPLETED**

**SECTION PLAT**

330 Ft. from N. Line

..... Ft. from S. Line

..... Ft. from E. Line

330 Ft. from W. Line

0			

Location.....

Rig up.....

Drilling and Remarks:

*Top Bili h 3495*  
*Water 3497 T.D.*  
*P.B. to 3465*  
*S/3424-44*  
*Pump 75 lbs oil*  
*50" water*

**RECORD**

Cased..... in., ..... ft.

Sand.....

Gas.....

Oil.....

Total Depth 3497

**PRODUCTION**

1st 24 hrs. Nat.....

1st 24 hrs. after shot.....

Gas..... Cu. Ft.

Dry Hole.....

Abandoned.....

Date

JUN 1 0 1931

192

**CHAS. L. SHERWOOD** Scout