


Section 19 Township 19 Range 9 WWell No. # 5 LinkCompany Derby Oil & Carey Drlg.

NORTH

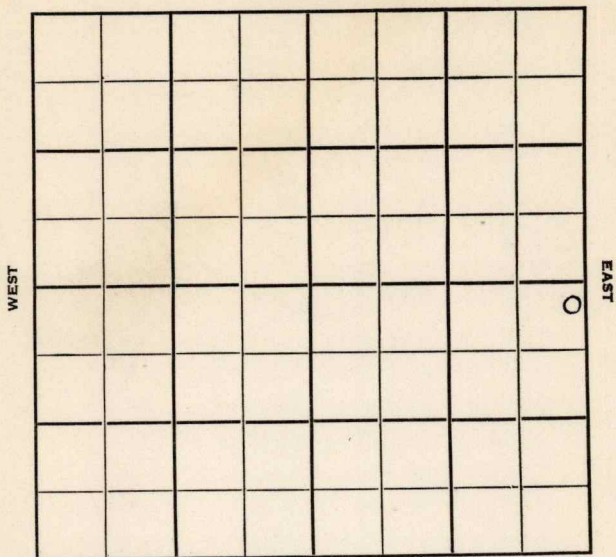

SOUTH

Rice

KANSAS

Sec. 19 **O.W.W.O.** Twp. 19 R. 9W ✓

Well No. #5 Link Farm

Derby Oil & Carey Drlg. Company

Carey Drlg.-Contr. Contractor

Chase Pool


285' Ft. from N. Line

Ft. from S. Line

185' Ft. from E. Line

Ft. from W. Line

NE NE SE

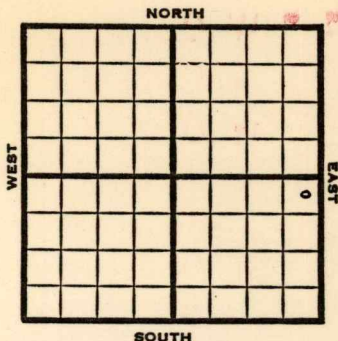

1951 **Elev. 1732'** REPORT

4/25 Location

6/20 Spud 5-7-51

Oil well TD 3255' 8" @ 225

Lans 2911' SO 2993-98'

DST 2988-98 open 8 min. rec 250' gas

& MCO **B KC 3185' Cong 3227'**

ReArb 3239' Arb. 3245' TD 3248'

4" @ 3247' DD 3255' 500 A

SP 3000 16/2980-84 20 GOPH

300 A F/28½ BO 1 hr. 16½ BO 2nd hr

Comp. 200 BOPD

COMPLETED

1952
8/20

Lans. 2911-prod. Cong. 3227

Re Arb. 3239 Arb. 3245

OTD 3256 4" @ 3247' CO 3256

S/ 9 Boph POP

8/27
9/4

NR

Oil Well TD 3256

Lans. 3245 Cong. 3227 O.W.W.O.

ReArb. 3239 Arb. 3245

OTD 3256 4" @ 3247 CO to 3256

S/ 9 boph Comp. 36 bopd 32 bw

COMPLETED

O.W.W.O.

County	Rice		State	Kansas	
Sec.	19	(Blk.) (Twp.)	19	(Sur.) (Rge.)	9W
Map No.					

Sec. 19 (Blk.) 19 (Sur.) 9W Map No.

Operator Derby Oil & Carey Drllg.

Well No. **5** Farm **Link**

Elev.	Location	NE	NE	SE
60	100			
70	200			
80	300			
1000	9500			

285 Ft. From N Line SE

185 Ft. From E Line Quarter

1st. Report APR 25 1951

Completion

Remarks

Carey Drlg. - Contr.


Spudding Date

Drlg. Data

Chase Pool

Location

J. E. TYRA

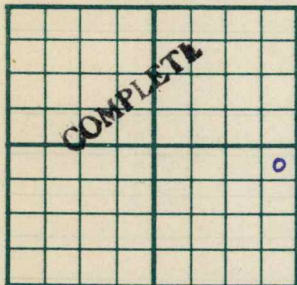County Rice State KansasSec. 19 (Blk. Twp.) 19 (Sur. Rge.) 9W Map No.Operator Derby Oil & Carey Drlg.Well No. 5 Farm LinkElev. 1732 Location NE NE SE285 Ft. From N Line SE185 Ft. From E Line Quarter

1st. Report

Completion JUN 20 1951Remarks Chase PoolCarey Drlg. - Contr.Spudding Date 5-7-51Drlg. Data Oil well TD 32558" @ 225 Lans. 2911 SO 2993-98DST 2988-98 open 8 min. Rec. 250' gas& mco B KC 3185 Cong. 3227 ReArb. 3239Arb. 3245 TD 3248 4" @ 3247 DD 3255500 A SP 3000 16/ 2980-84 20 goph300 A F/ 28 $\frac{1}{2}$ bo 1 hr. 16 $\frac{1}{2}$ bo 2nd hr.Comp. 200 bopd

J. E. T. 1100

County **Rice** State **Kansas**
 Sec. **19** (Blk.) **19** (Sur.) **9W** Map No.

Operator **Derby Oil**

Well No. **5** Farm **Link**

Elev. **1734** Location **NE NE SE**

FIRST REPORT

330 Ft. From **N** Line **SE**

330 Ft. From **E** Line Quarter

1st. Report **AUG 20 1952**

Completion

Remarks

OWWO O.W.W.O.

Spudding Date

Drlg. Data

Lans 2911-prod. Cong 3227 Re Arb 3239

Arb 3245 OTD 3256 4" @ 3247 - Co 3256

S/9 Boph pop.

J. G. McGEHEE

County Rice State Kansas
 Sec. 19 (Blk. Twp.) 19 (Sur. Rge.) 9W Map No.
 Operator Derby Oil
 Well No. 5 Farm Link
 Elev. 1734 Location NE NE SE



330 Ft. From N Line SE
330 Ft. From E Line Quarter

1st. Report

Completion SEP 4 1952

Remarks OWWO

Spudding Date

Drlg. Data Oil well TD 3256
Lans. 2911 Cong. 3227 ReArb. 3239
Arb. 3245 OTD 3256 4" @ 3247
CO to 3256 S/ 9 boph
Comp. 36 bopd 32 bw