


Section 4 Township 21 Range 3W

Well No. 1 Krehbiel

Company Chas. Petrey et al

Voshell Pool

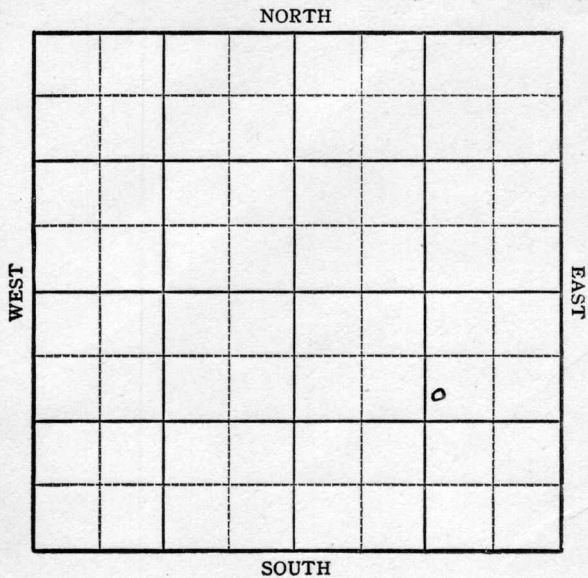

Sec. 4 Twp. 21 R. 3W ✓

Well No. #1 Krehbiel Farm

Chas. Petrey et al Company


Voshell Pool

990' Ft. from N. Line

_____ Ft. from S. Line

1104' Ft. from E. Line

_____ Ft. from W. Line

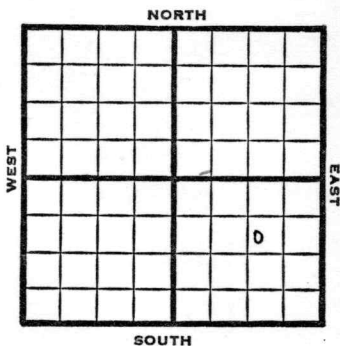

SW NE SE

1949 Elev 1446' REPORT

1/12	All wells plugged 8" @ 227'
1/19	Drlg. 2730' Miss 2984' Viola 3200' Simp 3326-28' TD 3328' 5" @ 3327'
1/26	"
2/2	"
2/9	"
2/16	"
2/23	TD 3333'
3/2	Drlg. 3372' SSO & W
3/8	Arb. 3379-85' TD 3385' 2000' oil / 200' W 36 hrs.
3/16	30 qts 3345-70 - 1000' oil & 500' W
3/22	"
3/30	"
4/6	"
4/12	TD 3387' Pump 20 bbls oil & 150 W - 24 hrs. PB
4/20	"
4/27	"
5/4	"

OVER

1949

5/10 TD 3387'
Pump 20 b ls. oil & 150 W 24 hrs
PB

5/18 TD 3387'
Arb. 3379'
5" @ 3327'
30 qts
Pump 52 Oil / wtr.
42° Gr.
Comp

COMPLETED

Kansas

Map No. _____ Sec. 4 Twp. 21 R. 3W

Well No. 1 Krehbiel

Chas. Petrey etal. Company

FIRST REPORT Contractor

SW NE SE

SECTION PLAT

990 Ft. from N. Line

_____ Ft. from S. Line

1104 Ft. from E. Line

_____ Ft. from W. Line

McPherson County

Location _____

Rig up _____

Drilling and Remarks:

All wells plugged

8" @ 227

drlg. 2730

RECORD

Cased _____ in., _____ ft.

Sand _____

Gas _____

Oil _____

Total Depth _____

PRODUCTION

1st 24 hrs. Nat. _____

1st 24 hrs. after shot _____

Gas _____ Cu. Ft.

Dry Hole _____

Abandoned _____

Date

JAN 1 2 1949 19

S. J. LEWIS

Scout

Map No. K43 Sec. 4 Twp. 21 R. 3W

Well No. 1 Krenbiel

Chas. Petrie etal. Company

COMPLETE Contractor

SW NE SE

E. 11446
SECTION PLAT

990 Ft. from N. Line

_____ Ft. from S. Line

1104 Ft. from E. Line

_____ Ft. from W. Line

McPherson County

Location _____

Rig up _____

Drilling and Remarks:

AL 43374
5" casing
30 ft
Run 52 oil + water
42 2/3

RECORD

Cased _____ in., _____ ft.

Sand _____

Gas _____

Oil _____

Total Depth 3387

PRODUCTION

1st 24 hrs. Nat. _____

1st 24 hrs. after shot _____

Gas _____ Cu. Ft.

Dry Hole _____

Abandoned _____

Date

MAY 18 1949

19

S. J. LEWIS

Scout