


Map No. KANSAS Sec. 4 Twp. 21 R. 3^w

Well No. 2 - Grebbil Farm
Cravel Oil Company

_____ Ft. from N. Line
330 Ft. from S. Line
990 Ft. from E. Line
1929 Ft. from W. Line

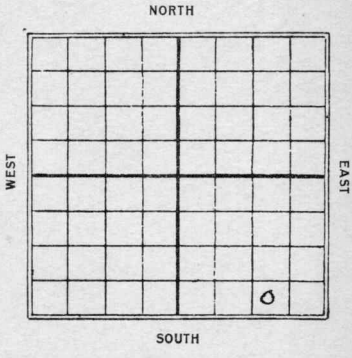

Date	REPORT
12/23	ROG
12/30	—
1930	—
1/8	—
1/15	—
1/22	—
1/29	Rgn up
2/5	—
2/12	Wrlg 600'
2/19	T.D. 1785 crooked hole P.B to 800
2/26	T.D. 800' Cement hole.
3/5	Wrlg. 900'
3/12	" 1620'
3/19	" 2405'
3/26	" 2945'
4/2	" 3210'
4/9	8" - 3210' Rust
4/16	Viola lime 3274-36 Top Wilcox 3251 Wrlg 3272 - 2100' oil line hole.

4/23- Viola 3224-36

Wileox 3251-72

Calc lime 3329-41

TD 3341

Swab 2153 lbl oil

Pump.

Map No. 43 **KANSAS** Sec. 4 Twp. 21 R. 3W

Well No. 2 Keeppiel

Prairie Oil & Gas Company

Contractor

SECTION PLAT

			0

_____ Ft. from N. Line

300 Ft. from S. Line

990 Ft. from E. Line

_____ Ft. from W. Line

FIRST REPORTS

Location _____

RECORD

Cased _____ in., _____ ft.

Sand _____

Gas _____

Oil _____

Total Depth _____

PRODUCTION

1st 24 hrs. Nat. _____

1st 24 hrs. after shot _____

Gas _____ Cu. Ft.

Dry Hole _____

Abandoned _____

Drilling and Remarks:

ROG

Date

DEC 23 1929

S. J. LEWIS

19

Scout

M. Pherson

Map No. **KANSAS** Sec. *4* Twp. *2* R. *3 IV*

Well No. *2 Kreckiel*

Prairie Oil & Gas Company

Contractor

SECTION PLAT

			0

.....Ft. from N. Line

330 Ft. from S. Line

990 Ft. from E. Line

.....Ft. from W. Line

COMPLETED

Location.....

Rig up.....

Drilling and Remarks:

Viola 3224-36

Wilcox 3251-72

Oil 3329-41

Swat 2103886

RECORD

Cased.....in.,ft.

Sand.....

Gas.....

Oil.....

Total Depth.....*3941*

PRODUCTION

1st 24 hrs. Nat.....

1st 24 hrs. after shot.....

Gas.....Cu. Ft.

Dry Hole.....

Abandoned.....

Date

APR 23 1930

S. J. LEWIS

Scout