


M. Cherson

Map No. KANSAS Sec. 4 Twp. 21 R. 3^w

Well No. 5- Krekheil Farm
Barnsdall Company

NORTH

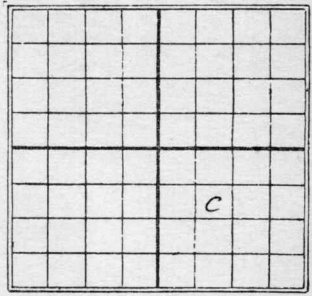

990 Ft. from N. Line

_____ Ft. from S. Line

_____ Ft. from E. Line

990 Ft. from W. Line

1930

Date

REPORT

Date	REPORT
4/30	Bldy Rig
5/7	Rig
5/14	Rig
5/21	hrlg. 2000'
5/28	" 2920'
6/4	Top Chat. 2965'
	Base Miss. Line 3015'
	hrlg. 3283'
6/11	Top Viola 3283'
	show oil 3290'
	hrlg.
6/18	Top Viola 3283'
	" Welox 3320'
	" Silc line 3380'
	TD 3394'
	swab 1205 bbl oil
	Comp.

W. Person
 Map No. **KANSAS** Sec. 4 Twp. 21 R. 3W
 Well No. 5 Freshfield

Barnwell Oil Company
 Contractor

SECTION PLAT

990 Ft. from N. Line
 Ft. from S. Line
 Ft. from E. Line
990 Ft. from W. Line

FIRST REPORTS

Location.....
 Rig up.....
 Drilling and Remarks:

*Rotary
 Building rig*

RECORD

Cased.....in.,ft.
 Sand.....
 Gas.....
 Oil.....
 Total Depth.....

PRODUCTION

1st 24 hrs. Nat.....
 1st 24 hrs. after shot.....
 Gas.....Cu. Ft.
 Dry Hole.....
 Abandoned.....

Date

APR 30 1930
 192.....

S. J. LEWIS Scout

Map No. KANSAS Sec. 4 Twp. 21 R. 3W

Well No. 5 Tree Hill

Barnwell Oil Company

Contractor

SECTION PLAT

990 Ft. from N. Line,

..... Ft. from S. Line

..... Ft. from E. Line

990 Ft. from W. Line

		0	

COMPLETED

Location.....

Rig up.....

Drilling and Remarks:

Top Viola 3283

Willow 3320

Oil line 3390

swath 1205

RECORD

Cased..... in., ft.

Sand.....

Gas.....

Oil.....

Total Depth 3394

PRODUCTION

1st 24 hrs. Nat.....

1st 24 hrs. after shot.....

Gas..... Cu. Ft.

Dry Hole.....

Abandoned.....

Date

JUN 18 1930

S. J. LEWIS

Scout