

KANSAS

Rice

FORM 51 5M 1-42 PETROL

Section 19 Township 19 Range 9-W

Well No. 1 Link


Company Skelly

Chase Pool

NORTH

WEST

EAST

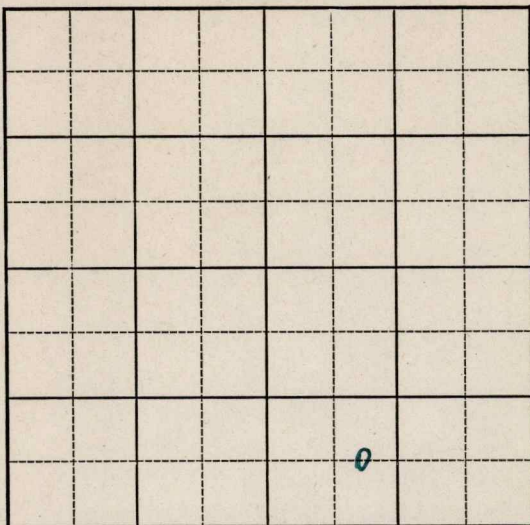

SOUTH

KANSAS

Rice

Map No. 49 Sec. 19 Twp. 19 R. 9WWell No. 1 Link


Skelly

Company

FIRST REPORT

Contractor

C EL SW SE

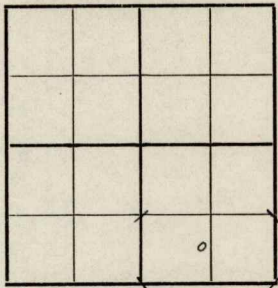SECTION PLAT Ft. from N. Line660 Ft. from S. Line Ft. from E. Line990 Ft. from W. Line

CHASE POOL

Location Rig up

Drilling and Remarks:

Derrick

RECORDCased in., ft.Sand Gas Oil Total Depth **PRODUCTION**1st 24 hrs. Nat. 1st 24 hrs. after shot Gas Cu. Ft.Dry Hole Abandoned

Date

FEB 1 8 1942 19S. J. LEWIS Scout

Rice

KANSAS

Map No. 49 Sec. 19 Twp. 19 R. 9WWell No. 1 LinkSkelly CompanyABANDONED Contractor

SECTION PLAT

C EL SW SE

 Ft. from N. Line660 Ft. from S. Line Ft. from E. Line990 Ft. from W. Line

CHASE POOL

RECORD

Location Cased in., ft.Rig up Sand

Drilling and Remarks:

Gas Oil Total Depth 3290

PRODUCTION

1st 24 hrs. Nat. 1st 24 hrs. after shot Gas Cu. Ft.Dry Hole Abandoned

Date

MAR 1 1 1942

19

S. J. LEWIS

Scout