


Map No. KANSAS Sec. 3 Twp. 21 R. 3^w
 Well No. 3-1 Frebbel Farm
Bypsy Oil Company
 NORTH

990 Ft. from N. Line
 _____ Ft. from S. Line
 _____ Ft. from E. Line
330 Ft. from W. Line
1930

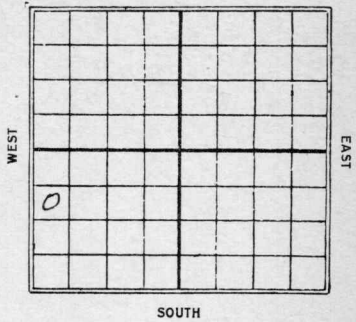

Date	REPORT
4/2	Roy rotary
4/9	Spud
4/16	hrlg. 1621
4/23	" 2660'
4/30	Top Chat 3040 T.D. 3265' fsg. tool
5/7	Top Viola 3407 set 8" Rust
5/14	T.D. 3407- 2VA gas-spray oil
5/21	Wilcox 3445-53 T.D. Swab 370 bbls 7 1/2 hrs.
5/28	Wilcox 3445-51' TD 3451 Pump 372 bbl oil Comp.

Map No. KANSAS Sec. 3 Twp. 21 R. 2W

Well No. ⁴³ 3 Necktie

Gyrgyz Oil Company

Contractor

SECTION PLAT

990 Ft. from N. Line

..... Ft. from S. Line

..... Ft. from E. Line

330 Ft. from W. Line

FIRST REPORTS

Location.....

Rig up.....

Drilling and Remarks:

ROG
Rotary

RECORD

Cased..... in., ft.

Sand.....

Gas.....

Oil.....

Total Depth.....

PRODUCTION

1st 24 hrs. Nat.....

1st 24 hrs. after shot.....

Gas..... Cu. Ft.

Dry Hole.....

Abandoned.....

Date

APR 2 - 1930

192.....

S. J. LEWIS

Scout

Map No. *43* **KANSAS** Sec. *3* Twp. *21* R. *2W*

Well No. *3 Kreschiel*

Gayney Oil Company
Contractor

SECTION PLAT

990 Ft. from N. Line

..... Ft. from S. Line

..... Ft. from E. Line

330 Ft. from W. Line

<i>0</i>			

COMPLETED

Location.....

Rig up.....

Drilling and Remarks:

Wilcox 3445-51

Pump 372 X 1/2

RECORD

Cased..... in., ft.

Sand.....

Gas.....

Oil.....

Total Depth *3451*

PRODUCTION

1st 24 hrs. Nat.....

1st 24 hrs. after shot.....

Gas..... Cu. Ft.

Dry Hole.....

Abandoned.....

Date

MAY 28 1930

S. J. LEWIS Scout