


M^cPherson
 Map No. KANSAS Sec. 3 Twp. 21 R. 3^w
 Well No. 42 Freshhill Farm
Lypsy Oil Company

NORTH

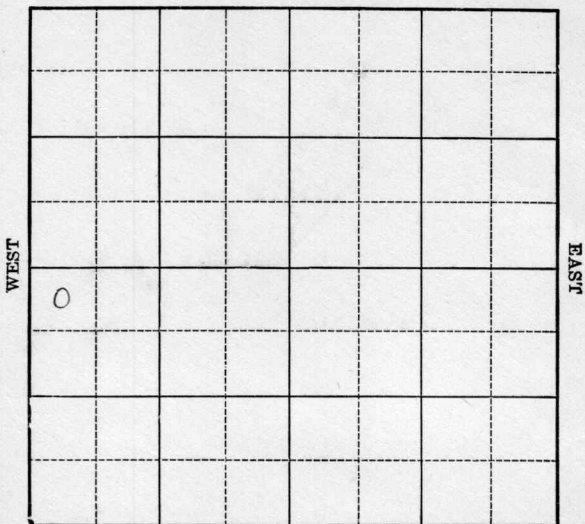

SOUTH

Location _____
 Drilling Remarks _____

Rig Up _____
 Drilling Remarks _____

RECORD
 Cased _____ in. _____ ft.
 Sand _____
 Gas _____
 Oil _____
 Total Depth _____

PRODUCTION
 1st 24 hrs. Nat. _____
 1st 24 hrs. after shot _____
 Gas _____ cu. ft.
 Dry Hole _____
 Abandoned _____

Map No. KANSAS Sec. 3 Twp. 21 R. 3^W
 Well No. H. J. Krekbril Farm
Gypsy Oil Company

NORTH


300 Ft. from N. Line

_____ Ft. from S. Line

_____ Ft. from E. Line

300 Ft. from W. Line

1930

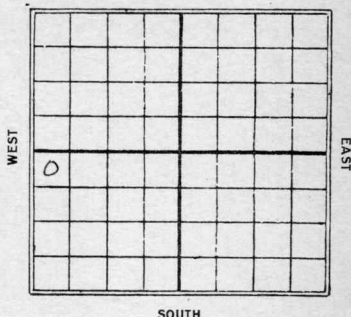

Date

REPORT

4/2	Rotary
4/9	Perfor. 540'
4/16	" 2435'
4/23	Top Chat 3088 Top Viola line 3407'- T.D. 3411 Run 8"
4/30	Top Wilcox 3446' T.D. 3449' Swab 280 bbls - 8 hrs.
5/7	T.D. 3449' - Swab 844 bbls in 24 hrs.
5/14	Wilcox 3446-49 1/2 T.D. 3449 1/2 swab 600 bbl oil Comp.
1932	OWDD
12/28	Old TD 3449 1/2 Wilcox Top Pelic line 3495 Show oil 3495-96 1000 ft water 3502-04 T.D. 3504 Will P.B. to Wilcox

1433

1/4. TD 3504

PB. to 3453

shot 40 qt 3441-53
show oil & water

1/11. Top Welcox 3446
" Calc. lime 3495
Water 3502-04

TD 3504

PB. 3453

shot 40 qt 3441-53
Dry & Abandon

Map No. KANSAS Sec. 3 Twp. 21 R. 2W

Well No. 43 4 Krehziel

Gypsum Oil Company

Contractor

SECTION PLAT

800 Ft. from N. Line

..... Ft. from S. Line

..... Ft. from E. Line

800 Ft. from W. Line

FIRST REPORTS

Location.....

Rig up.....

Drilling and Remarks:

ROG.
Rotary

RECORD

Cased.....in.,ft.

Sand.....

Gas.....

Oil.....

Total Depth.....

PRODUCTION

1st 24 hrs. Nat.....

1st 24 hrs. after shot.....

Gas.....Cu. Ft.

Dry Hole.....

Abandoned.....

Date

APR 2 - 1930

S. J. LEWIS Scout

Map No. **KANSAS** Sec. 3 Twp. 21 R. 3W

Well No. 43 4 Trecheil

Gypsy Oil Company

Contractor

SECTION PLAT

300 Ft. from N. Line

Ft. from S. Line

Ft. from E. Line

330 Ft. from W. Line

COMPLETED

Location

Rig up

Drilling and Remarks:

Wilcox 3446-49 1/2

swab 600 ft

RECORD

Cased 1 in., ft.

Sand

Gas

Oil

Total Depth 3449 1/2

PRODUCTION

1st 24 hrs. Nat.

1st 24 hrs. after shot

Gas Cu. Ft.

Dry Hole

Abandoned

Date

MAY 14 1930

S. J. LEWIS Scout

43 KANSAS

Map No. _____ Sec. 3 Twp. 21 R. 3 W

Well No. 4 Krehbiel

Gypsy Oil Co. Company

Contractor

FIRST REPORTS


SECTION PLAT

300 Ft. from N. Line

_____ Ft. from S. Line

_____ Ft. from E. Line

300 Ft. from W. Line

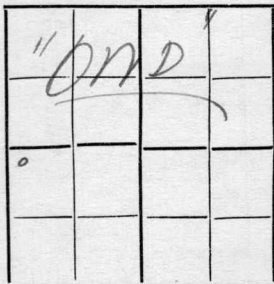

Location _____

Rig up _____

Drilling and Remarks:

Blo T. O. 34 39 1/2
 Top Siliceous 3495
 Show oil 3495-96
 100% Water 3502-04
 Miss P B to Nulcor

RECORD

Cased _____ in., _____ ft.

Sand Nulcor 3446-49 1/2

Gas _____

Oil _____

Total Depth _____

PRODUCTION

1st 24 hrs. Nat. _____

1st 24 hrs. after shot _____

Gas _____ Cu. Ft.

Dry Hole _____

Abandoned _____

Date

DEC 23 1932 CHAS. L. SHERWOOD

192

Scout

43 KANSAS Sec. 3 Twp. 21 R. 3 W

Well No. 4 Krehbie

Gypsy Oil Co Company

Contractor

COMPLETED

300 Ft. from N. Line

Ft. from S. Line

Ft. from E. Line

300 Ft. from W. Line

SECTION PLAT

o			

ABANDONED

Location

Rig up

Drilling and Remarks:

Top Siliceous 3495

Water 3502.04

P. B. 3453

Shot 40/3441-53

RECORD

Cased in, ft.

Sand Vulcor 3446

Gas

Oil

Total Depth 3504

PRODUCTION

1st 24 hrs. Nat.

1st 24 hrs. after shot

Gas Cu. Ft.

Dry Hole ✓

Abandoned ✓

Date

JAN 1 1 1933

192

CHAS. L. SHERWOOD

Scout