


Map No. KANSAS Sec. 3 Twp. 21 R. 3^w

Well No. 1 - Moore house Farm
G. H. Marland, Inc Company

NORTH

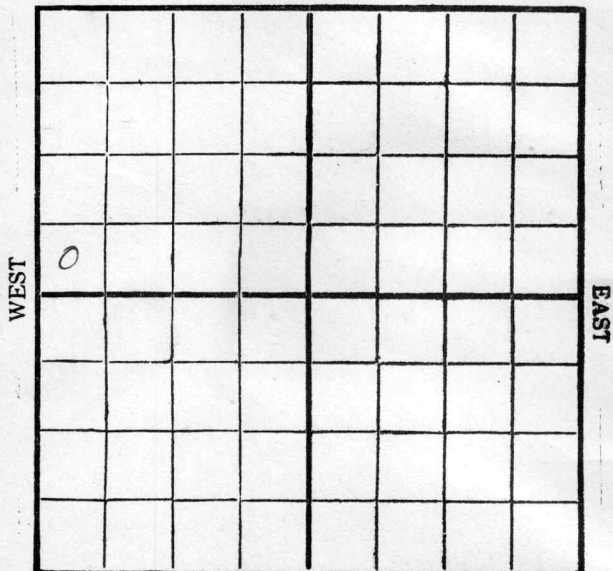

SOUTH

Location _____

Drilling Remarks _____

Rig Up _____

Drilling Remarks _____

RECORD


Cased _____ in. _____ ft.
Sand _____
Gas _____
Oil _____
Total Depth _____

PRODUCTION

1st 24 hrs. Nat. _____
1st 24 hrs. after shot _____
Gas _____ cu. ft. _____
Dry Hole _____
Abandoned _____

Map No. KANSAS Sec. 3 Twp. 21 R. 3^w
Well No. E. Moorehouse Farm
C. N. Marland, Inc. Company

NORTH

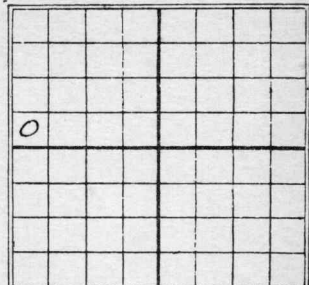

_____ Ft. from N. Line
330 Ft. from S. Line
_____ Ft. from E. Line
330 Ft. from W. Line

1930

Date	REPORT
<u>1/8</u>	<u>Location</u>
<u>1/15</u>	<u>—</u>
<u>1/22</u>	<u>Bldg Rig</u>
<u>1/29</u>	<u>Spind</u>
<u>2/5</u>	<u>set 15 1/2" - 146'</u>
<u>2/12</u>	<u>—</u>
<u>2/19</u>	<u>Outg 1195</u>
<u>2/26</u>	<u>" 2150.</u>
<u>3/5</u>	<u>" 2730</u>
<u>3/12</u>	<u>" 3098 Top Chat</u>
	<u>3026.</u>
<u>3/19</u>	<u>Top Viola 3377-</u>
	<u>Outg. 3392'</u>
<u>3/28</u>	<u>Top Wilcox 3408</u>
	<u>First oil 3415</u>
	<u>T.D. 3419 swabbing</u>
	<u>35 bbl per hour</u>
<u>4/2</u>	<u>T.D. 3423 Swabbed</u>
	<u>798 bbls 24 hrs.</u>
<u>4/9</u>	<u>—</u>
<u>4/16</u>	<u>T.D. 3425 - Swab</u>
	<u>900 bbls 24 hrs.</u>

4/23- Viola 3377-3403

Whitcox 3408-23

TD. 3423

swab 900 bbl oil
Comp.

Map No. 43 KANSAS Sec. 3 Twp. 21 R. 3W

Well No. 1 Horse house

E. W. Warland Inc Company

Contractor

SECTION PLAT

0			

_____ Ft. from N. Line

380 Ft. from S. Line

_____ Ft. from E. Line

380 Ft. from W. Line

FIRST REPORTS

Location ✓

Rig up _____

Drilling and Remarks:

RECORD

Cased _____ in., _____ ft.

Sand _____

Gas _____

Oil _____

Total Depth _____

PRODUCTION

1st 24 hrs. Nat. _____

1st 24 hrs. after shot _____

Gas _____ Cu. Ft.

Dry Hole _____

Abandoned _____

Date

JAN 8 1930
19

S. J. LEWIS Scout

Map No. *43* **KANSAS** Sec. *8* Twp. *21* R. *3W*

Well No. *1 Model house*

E. W. Maryland Inc Company

Contractor

SECTION PLAT

0			

.....Ft. from N. Line

250 Ft. from S. Line

.....Ft. from E. Line

250 Ft. from W. Line

COMPLETED

Location.....

Rig up.....

Drilling and Remarks:

Viola 8377-8403
Willcox 8408-23


RECORD

Cased.....in.,ft.

Sand.....

Gas.....

Oil.....

Total Depth *3423*

PRODUCTION

1st 24 hrs. Nat.....

1st 24 hrs. after shot.....

Gas.....Cu. Ft.

Dry Hole.....

Abandoned.....

Date

APR 23 1930

192

S. J. LEWIS

Scout